


STATE OF KANSAS
STATE CORPORATION COMMISSION

Give All Information Completely
Make Required Affidavit
Mail or Deliver Report to:
Conservation Division
State Corporation Commission
212 No. Market
Wichita, Kansas

WELL PLUGGING RECORD

NORTH

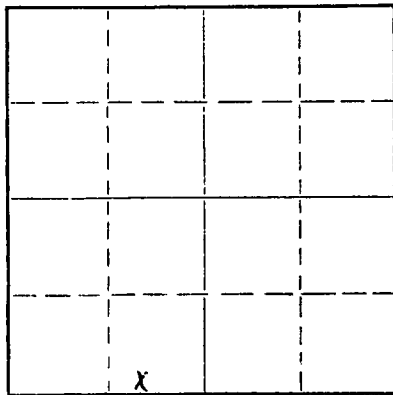

Locate well correctly on above Section Flat

Graham County. Sec. 33 Twp. 9 Rge. 23 (E) W (W)
Location as "NE/CNW%SW%" or footage from lines SW SE SW
Lease Owner Et Al, Inc.
Lease Name Rice Well No. 1
Office Address 501 Cameron Bldg., Oklahoma City, Okla.
Character of Well (completed as Oil, Gas or Dry Hole) Dry Hole
Date well completed October 26, 1967
Application for plugging filed October 26, 1967
Application for plugging approved October 26, 1967
Plugging commenced October 26, 1967
Plugging completed October 26, 1967
Reason for abandonment of well or producing formation Dry Hole

If a producing well is abandoned, date of last production _____ 19____
Was permission obtained from the Conservation Division or its agents before plugging was commenced? Yes

Name of Conservation Agent who supervised plugging of this well W. L. Nichol
Producing formation _____ Depth to top _____ Bottom _____ Total Depth of Well 3797 Feet
Show depth and thickness of all water, oil and gas formations.

OIL, GAS OR WATER RECORDS

CASING RECORD

FORMATION	CONTENT	FROM	TO	SIZE	PUT IN	PULLED OUT
		0	225	7"	215	

Describe in detail the manner in which the well was plugged, indicating where the mud fluid was placed and the method or methods used in introducing it into the hole. If cement or other plugs were used, state the character of same and depth placed, from _____ feet to _____ feet for each plug set.

1 Plug at 1200' W/100 Sacks Cement
2 Plug at 270' W/20 Sacks Cement
3 Plug at 40' W/10 Sacks Cement

11-6-67

NOV 6 1967

(If additional description is necessary, use BACK of this sheet)
Name of Plugging Contractor Halliburton
Address Hill City, Kansas


STATE OF Kansas COUNTY OF Graham, ss.
Louis Edgett (employee or owner) or (owner or operator) of the above-described well, being first duly sworn on oath, says: That I have knowledge of the facts, statements, and matters herein contained and the log of the above-described well as filed and that the same are true and correct. So help me God.

(Signature) Louis Edgett
P O Box D, Hill City, Kansas
(Address)

SUBSCRIBED AND SWORN TO before me this 2nd day of November, 1967

My commission expires January 20, 1968

Carol Drexler Notary Public.

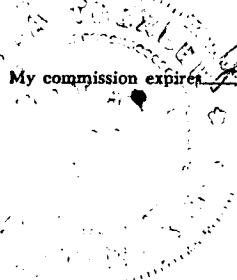

CONTRACTOR'S WELL LOG

COMPANY: ET AL, Inc.
 CONTRACTOR: PAINE DRILLING CO., Inc.
 WELL: RICE # 1
 LOCATION: SW SE SW Sec. 33-9-23
 GRAHAM COUNTY, KANSAS
 COMMENCED: OCTOBER 20, 1967
 COMPLETED: OCTOBER 26, 1967
 2469' KB

0	226	Surface Soils
226	1170	Shale & Sand
1170	2064	Sand & Shale
2064	2100	Anhydrite
2100	2475	Shale & Shells
2475	2895	Lime & Shale
2895	2940	Lime & Shells
2940	3140	Lime & Shale
3140	3790	Shale & Lime
3790	3797	Lime

RECEIVED
 NOV 3 1967
 COMMISSIONER OF REVENUE
 CONSERVATION DIVISION
 Topeka, Kansas

SET 7 " SURFACE PIPE AT 226' W/125 SACKS CEMENT W/HA5

DRY & ABANDONED

WE HEREBY CERTIFY THAT THE ABOVE IS A CORRECT AND ACCURATE LOG OF THE ABOVE MENTIONED WELL, AS SHOWN ON THE DAILY DRILLING REPORTS.

PAINE DRILLING CO., INC.

BY Louis Edgett
 BOOKKEEPER

SUBSCRIBED AND SWORN TO BEFORE ME THIS 31st DAY OF OCTOBER, 1967.

Bryan B. Parker
 NOTARY PUBLIC

