

STATE OF KANSAS  
STATE CORPORATION COMMISSION

WELL PLUGGING RECORD

Give All Information Completely  
Make Required Affidavit  
Mail or Deliver Report to  
Conservation Division  
State Corporation Comm.  
245 North Water  
Wichita, KS 67202

Graham County, Sec. 34 Twp. 9s Rge. 23 E/W  
Location as "NE/CNW $\frac{1}{4}$ SW $\frac{1}{4}$ " or footage from lines  
440' fe1 & s1 SW/4

Lease Owner Don Pratt  
Lease Name Law "D" Well No. 1

Office Address Drawer 370, Hays, Ks  
Character of Well (Completed as Oil, Gas or Dry Hole) Dry Hole

Date Well completed 10/10 1977  
Application for plugging filed 10/10 1977  
Application for plugging approved 10/10 1977  
Plugging commenced 10/10 1977  
Plugging completed 10/10 1977


Reason for abandonment of well or producing formation Dry Hole

If a producing well is abandoned, date of last production 19

Was permission obtained from the Conservation Division or its agents before plugging was commenced? Yes

Name of Conservation Agent who supervised plugging of this well Gilbert Balthazor  
Producing formation Depth to top Bottom Total Depth of Well 4173'

Show depth and thickness of all water, oil and gas formations.

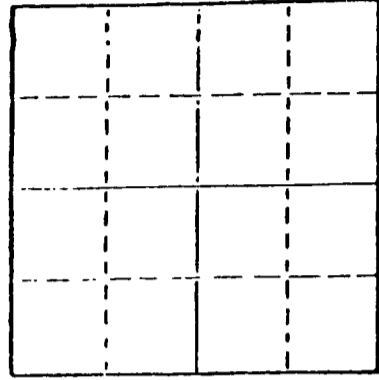

Locate well correctly on above Section Plat

OIL, GAS OR WATER RECORDS

CASING RECORD

FORMATION	CONTENT	FROM	TO	SIZE	PUT IN	PULLED OUT
				8 5/8"	168'	None

Describe in detail the manner in which the well was plugged, indicating where the mud fluid was placed and the method or methods used in introducing it into the hold. If cement or other plugs were used, state the character of same and depth placed, from feet to feet.

1st plug @ 1000' w/70 sx  
2nd plug @ 150' w/20 sx  
3rd plug @ 40' w/10 sx

RECEIVED FOR SECTION  
STATE CORPORATION COMMISSION  
10-21-77  
OCT 21 1977  
CONSERVATION DIVISION  
Wichita, Kansas

(If additional description is necessary, use BACK of this sheet)

Name of Plugging Contractor Allied Cmtg

STATE OF Kansas COUNTY OF Sedgwick, ss.  
Wm. S. Shropshire (employee of owner)

of the above-described well, being first duly sworn on oath, says: That I have knowledge of the facts, statements, and matters herein contained and the log of the above-described well as filed and that the same are true and correct. So help me God.

(Signature) Wm. S. Shropshire  
617 Union Center, Wichita, Kansas 67202  
(Address)

SUBSCRIBED AND SWORN TO before me this 20th day of October, 1977

JOLENE S. FRISBIE, STATE NOTARY PUBLIC  
My Comm. Exp. March 13, 1979  
Jolene S. Frisbie  
Notary Public.

