


WELL PLUGGING RECORD

Give All Information Completely
Make Required Affidavit
Mail or Deliver Report to:
Conservation Division
State Corporation Commission
212 No. Market
Wichita, Kansas

Ellis County, Sec. 23 Twp. 11 Rge. 16 (E) W (W)

Location as "NE/CNW/SW" or footage from lines NE NE SE
Lease Owner Shields Oil Producers, Inc. & Prospect Oil, Inc.
Lease Name Bowlby Well No. 1
Office Address Shields Building, Russell, Kansas
Character of Well (completed as Oil, Gas or Dry Hole) Dry hole
Date well completed December 4, 1968
Application for plugging filed December 4, 1968
Application for plugging approved December 4, 1968
Plugging commenced December 4, 1968
Plugging completed December 4, 1968
Reason for abandonment of well or producing formation Dry hole

NORTH

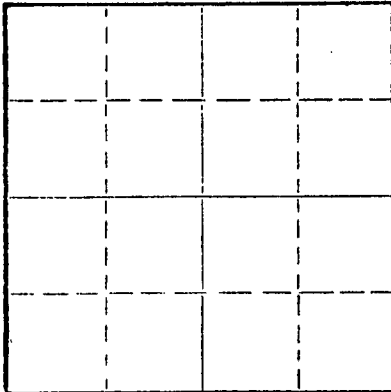

Locate well correctly on above
Section Plat

If a producing well is abandoned, date of last production 19
Was permission obtained from the Conservation Division or its agents before plugging was commenced? Yes

Name of Conservation Agent who supervised plugging of this well Leo Massey
Producing formation _____ Depth to top _____ Bottom _____ Total Depth of Well 3,061 Feet
Show depth and thickness of all water, oil and gas formations.

OIL, GAS OR WATER RECORDS

CASING RECORD

| FORMATION | CONTENT | FROM | TO | SIZE | PUT IN | PULLED OUT |
|-----------|---------|------|----|--------|--------|-----------------|
| | | | | 8 5/8" | 251' | Cmtd. w/175 sax |
| | | | | | | |
| | | | | | | |
| | | | | | | |
| | | | | | | |
| | | | | | | |
| | | | | | | |
| | | | | | | |

Describe in detail the manner in which the well was plugged, indicating where the mud fluid was placed and the method or methods used in introducing it into the hole. If cement or other plugs were used, state the character of same and depth placed, from _____ feet to _____ feet for each plug set.

Fill w/ heavy mud to 600'
Set bridge plug @ 600'
Pump 50 sax cement on plug thru 4 1/2" drill pipe
Fill w/ heavy mud to 240'
Set bridge plug @ 240'
Pump 25 sax cement on plug thru 4 1/2" drill pipe
Fill w/ heavy mud to 40'
Set bridge plug @ 40' w/ 1/2 sax hulls on plug
Dump 10 sax cement on plug to cellar

RECEIVED
STATE CORPORATION COMMISSION
JAN 27 1969
CONSERVATION DIVISION
Wichita, Kansas

(If additional description is necessary, use BACK of this sheet)

Name of Plugging Contractor Shields Drilling Co., Inc.
Address Shields Building, Russell, Kansas

STATE OF Kansas, COUNTY OF Russell, ss.
R. L. Shields (employee of owner) or (owner or operator) of the above-described

well, being first duly sworn on oath, says: That I have knowledge of the facts, statements, and matters herein contained and the log of the above-described well as filed and that the same are true and correct. So help me God.

(Signature) R. L. Shields, vice pres.
Shields Building, Russell, Kansas
(Address)

SUBSCRIBED AND SWORN TO before me this 22nd day of January, 1969

My commission expires May 26, 1971

Notary Public.




Shields 15-051-20353-02-00 Kansas

WELL LOG

Operator: Shields Oil Producers, Inc.
 Well: Bowlby #1
 Commenced: November 30, 1968
 Completed: December 4, 1968
 Contractor: Shields Drilling Co., Inc.

Well Description: NE NE SE
 Sec. 23-11S-16W
 Ellis Co., Kansas

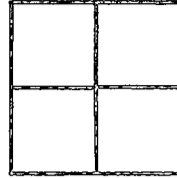

CASING RECORD

| Size | Run | Pulled |
|--------|------|------------------|
| 8 5/8" | 251' | Cmtd. w/ 175 sax |

Elevation: 1,851' RB
 Treatment:
 Production: D & A
 Tops: Heebner 3,033'

..... Figures Indicate Bottom of Formations

| | |
|------------------------------|------------|
| Sand & shale | 255' |
| Sand, shale, shells & redbed | 1,019' |
| Anhydrite | 1,055' |
| Shale, shells & salt | 1,500' |
| Shale & lime | 2,740' |
| Lime | 3,061' RTD |

RECEIVED
 STATE CORPORATION COMMISSION
 JAN 27 1969
 CONSERVATION DIVISION
 Wichita, Kansas

Notes