


STATE OF KANSAS
STATE CORPORATION COMMISSION

WELL PLUGGING RECORD

Give All Information Completely
Make Required Affidavit
Mail or Deliver Report to
Conservation Division
State Corporation Comm.
245 North Water
Wichita, KS 67202

Graham County, Sec. 13 Twp. 9 Rge. 24W NW
Location as "NE/CNW $\frac{1}{2}$ SW $\frac{1}{2}$ " or footage from lines CE/2 NE SE
NICKELSON OIL OPERATIONS
Lease Owner _____
Lease Name NICKELSON Well No. 13-1
Office Address RR #1 Box #1 Hill City, Kansas 67642
Character of Well (Completed as Oil, Gas or Dry Hole) _____

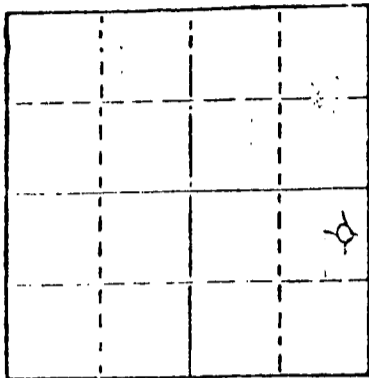

Locate well correctly on above
Section Plat

Dry Hole
Date Well completed 8-7-79 19
Application for plugging filed _____ 19
Application for plugging approved _____ 19
Plugging commenced 4-7-79 19
Plugging completed 4-7-79 19
Reason for abandonment of well or producing formation _____
Dry hole

If a producing well is abandoned, date of last production _____ 19

Was permission obtained from the Conservation Division or its agents before plugging was commenced? yes

Name of Conservation Agent who supervised plugging of this well Gilbert Balthazor
Producing formation Lansing-Kansas City to top 3800 Bottom 4000 Total Depth of Well 4005
Show depth and thickness of all water, oil and gas formations. 3992

ET REC

OIL, GAS OR WATER RECORDS

CASING RECORD

FORMATION	CONTENT	FROM	TO	SIZE	PUT IN	PULLED OUT
				8 5/8	200	0

Describe in detail the manner in which the well was plugged, indicating where the mud fluid was placed and the method or methods used in introducing it into the hold. If cement or other plugs were used, state the character of same and depth placed, from 1050' feet to 40' feet for each plug set.

- 1st. plug at 1050' with 70 sax cement
- 2nd plug at 200' with 20 sax cement
- 3rd. plug at 40' with 10 sax cement
- 5 sax in rat hole

(If additional description is necessary, use BACK of this sheet)

Name of Plugging Contractor Labanco Drilling Inc.

STATE OF Kansas COUNTY OF Graham, ss.
Ronald Nickelson (employee of owner) or (owner or operator)

of the above-described well, being first duly sworn on oath, says: That I have knowledge of the facts, statements, and matters herein contained and the log of the above-described well as filed and that the same are true and correct. So help me God.

RECEIVED
STATE CORPORATION COMMISSION

11-1-79
NOV 01 1979

(Signature) Ronald Nickelson
Rental Box 1 Hill City KS 67642
(Address)

SUBSCRIBER'S SWORN TO before me this 31st day of October, 1979
Wichita, Kansas

Debra L Daily
Notary Public.

My commission expires 5-12-82

