


STATE OF KANSAS
STATE CORPORATION COMMISSION

Form CP-4

Give All Information Completely
Make Required Affidavit
Mail or Deliver Report to:
Conservation Division
State Corporation Commission
212 No. Market
Wichita, Kansas 67202

WELL PLUGGING RECORD

NORTH

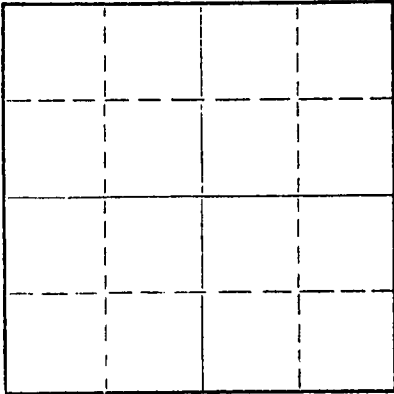

Locate well correctly on above
Section Plat

Graham County. Sec. 13 Twp. 9 Rge. 24 (E) W (W)

Location as "NE/CNWxSWx" or footage from lines NW NW SE
Lease Owner Don E. Pratt Oil Operations
Lease Name R. Nickelson Well No. 1
Office Address P. O. Drawer 370, Hays, Kansas 67601
Character of Well (completed as Oil, Gas or Dry Hole) Dry Hole
Date well completed 9-7 1970
Application for plugging filed 9-7 1970
Application for plugging approved 9-7 1970
Plugging commenced 9-7 1970
Plugging completed 9-7 1970
Reason for abandonment of well or producing formation Dry Hole

If a producing well is abandoned, date of last production 19
Was permission obtained from the Conservation Division or its agents before plugging was commenced? Yes

Name of Conservation Agent who supervised plugging of this well Bill Nichols
Producing formation _____ Depth to top _____ Bottom _____ Total Depth of Well _____ Feet
Show depth and thickness of all water, oil and gas formations.

OIL, GAS OR WATER RECORDS

CASING RECORD

FORMATION	CONTENT	FROM	TO	SIZE	PUT IN	PULLED OUT
Surface pipe				8 5/8"	169'	

Describe in detail the manner in which the well was plugged, indicating where the mud fluid was placed and the method or methods used in introducing it into the hole. If cement or other plugs were used, state the character of same and depth placed, from _____ feet to _____ feet for each plug set.

1st plug was set at 1175' with 100 sacks cement
2nd plug was set at 185' with 20 sacks cement
3rd plug was set at 40' with 10 sacks cement

RECEIVED
STATE CORPORATION COMMISSION
9-11-70
SEP 11 1970
CONSERVATION DIVISION
Wichita, Kansas


(If additional description is necessary, use BACK of this sheet)

Name of Plugging Contractor L. J. Dreiling & Sons, Inc.
Address Victoria, Kansas 67671

STATE OF KANSAS, COUNTY OF ELLIS, ss.
I, Leo F. Dreiling (employee of owner) or (owner) of the above-described well, being first duly sworn on oath, says: That I have knowledge of the facts, statements, and matters herein contained and the log of the above described well as filed and that the same are true and correct. So help me God.

(Signature) Leo F. Dreiling
LEO F. DREILING ROUTE 2, VICTORIA, KANSAS 67671
(Address)

Subscribed and sworn to before me this 9th day of September, 1970

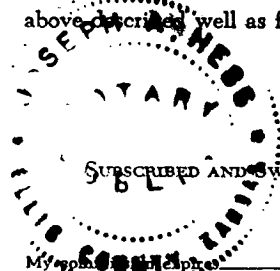

September 19, 1970

Joseph A. Hess
JOSEPH A. HESS Notary Public.

