


STATE OF KANSAS  
STATE CORPORATION COMMISSION

WELL PLUGGING RECORD

Give All Information Completely  
Make Required Affidavit  
Mail or Deliver Report to  
Conservation Division  
State Corporation Comm.  
245 North Water  
Wichita, KS 67202

Graham County, Sec. 15 Twp. 9 Rge. 24W E/W  
Location as "NE/CNW $\frac{1}{4}$ /SW $\frac{1}{4}$ " or footage from lines  
NE NE NW

Lease Owner Dupont Oil Company  
Lease Name Nickelson Well No. 1  
Office Address 660 Edgewater Road, Wichita, KS 67230  
Character of Well (Completed as Oil, Gas or Dry Hole)  
Dry Hole

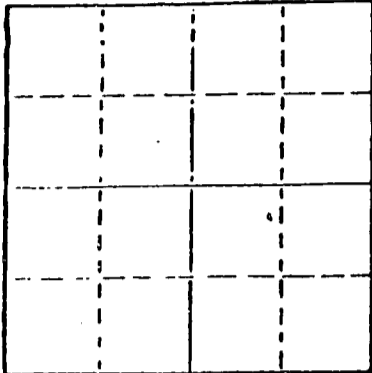

Locate well correctly on above  
Section Plat

Date Well completed Jan. 10 19 79  
Application for plugging filed (verbally) Jan 10 19 79  
Application for plugging approved (verbally) Jan 10 19 79  
Plugging commenced Jan 10 19 79  
Plugging completed Jan 10 19 79

Reason for abandonment of well or producing formation  
No commercial quantity of oil or gas encountered  
If a producing well is abandoned, date of last production  
19

Was permission obtained from the Conservation Division or  
its agents before plugging was commenced? Yes

Name of Conservation Agent who supervised plugging of this well Gilbert Balthazor  
Producing formation Depth to top Bottom Total Depth of Well 4050'  
Show depth and thickness of all water, oil and gas formations.

OIL, GAS OR WATER RECORDS

CASING RECORD

FORMATION	CONTENT	FROM	TO	SIZE	PUT IN	PULLED OUT

Describe in detail the manner in which the well was plugged, indicating where the mud fluid was placed and the method or methods used in introducing it into the hold. If cement or other plugs were used, state the character of same and depth placed, from feet to feet for each plug set.

T.D. 4050'  
Set 1st plug at 1000' with 70 sacks  
2nd plug at 240' with 20 sacks  
3rd plug at 40' solid bridge with 10 sacks  
rathole with 5 sacks.  
Cement by Sun Cement.  
Plug was down at 2:30 p.m., 1-10-79.  
State Plugger - Gilbert Balthazor.

RECEIVED  
STATE CORPORATION COMMISSION  
1-17-79  
JAN 17 1979  
CONSERVATION DIVISION  
Wichita, Kansas

(If additional description is necessary, use BACK of this sheet)

Name of Plugging Contractor Abercrombie Drilling, Inc.

STATE OF Kansas COUNTY OF Sedgwick, ss.  
Jack L. Partridge, Asst. Sec.-Treas. (employee of owner) or (owner or operator)  
of the above-described well, being first duly sworn on oath, says: That I have knowledge of  
the facts, statements, and matters herein contained and the log of the above-described well  
as filed and that the same are true and correct. So help me God.



(Signature) *Jack L. Partridge*  
801 Union Center, Wichita, Kansas 67202  
(Address)

SUBSCRIBED AND SWORN TO before me this 15th day of January, 19 79

*Sherrie L. Brooks*  
Sherrie L. Brooks Notary Public.

My commission expires 8-21-82.

CONTRACTOR'S WELL LOG

OPERATOR: Dupont Oil Company  
 CONTRACTOR: Abercrombie Drilling, Inc.  
 WELL NAME: Nichelson #1  
 LOCATION: NE NE NW, Section 15-9-24W  
 Graham County, Kansas  
 SPUD DATE: January 2, 1979  
 COMPLETION DATE: January 10, 1979

0	109	Sand and shale
109	276	Surface soil, sand & shale
276	1372	Sand and shale
1372	2155	Shale and sand
2155	2192	Anhydrite
2192	2813	Shale
2813	3000	Lime and shale
3000	3211	Shale and lime
3211	3885	Lime and shale
3885	3961	Lime
3961	3985	Lime and shale
3985	4023	Lime
4023	4050	Lime and shale
	4050	Rotary Total Depth

Spud hole at 8:30 p.m., January 2, 1979. Drilled 276' of 12 1/4" hole. Ran 6 joints of 8-5/8" - 28# casing. Set at 274' K.B. with 200 sacks of common cement, 3% Ca.Cl., 2% gel. Plug was down at 4:30 a.m., January 3, 1979.

T.D. 4050'. Set 1st plug at 1000' with 70 sacks, 2nd plug at 240' with 20 sacks, 3rd plug at 40' solid bridge with 10 sacks, rathole with 5 sacks. Cement by Sun Cement. Plug was down at 2:30 p.m., January 10, 1979.

SAMPLE TOPS:

Anhydrite 2155'  
 B/Anhydrite 2192'

RECEIVED  
 STATE CORPORATION COMMISSION

JAN 17 1979

STATE OF KANSAS )  
 ) ss  
 COUNTY OF SEDGWICK )


CONSERVATION DIVISION  
 Wichita, Kansas

Jack L. Partridge, Assistant Secretary-Treasurer of Abercrombie Drilling, Inc., does hereby state that the above and foregoing is a true and correct copy of the log of the Nichelson #1, NE NE NW, Section 15-9-24W, Graham County, Kansas.

ABERCROMBIE DRILLING, INC.

BY Jack L. Partridge  
 Jack L. Partridge  
 Assistant Secretary-Treasurer

Subscribed and sworn to before me, a Notary Public, in and for the county and state aforesaid, as of this 15th day of January, 1979.

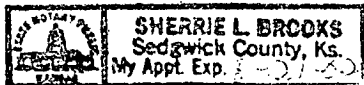

Sherrie Brooks  
 Sherrie Brooks, Notary Public

My commission expires 8-21-82.