

15-065-01077-0001

STATE OF KANSAS
STATE CORPORATION COMMISSION


Form CP-4

WELL PLUGGING RECORD

Give All Information Completely
Make Required Affidavit
Mail or Deliver Report to:
Conservation Division
State Corporation Commission
212 No. Market
Wichita, Kansas

Graham County, Sec. 14 Twp. 96 Rge. 24 (E) W (W)

NORTH

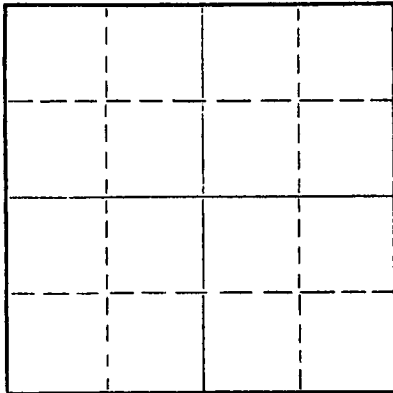

Locate well correctly on above
Section Plat

Location as "NE/CNW&SW&" or footage from lines _____
Lease Owner Petroleum Exploration
Lease Name ~~XXXXXXXX~~ Nickelson Well No. 1
Office Address 6210 West Tenth, Topeka, Kansas
Character of Well (completed as Oil, Gas or Dry Hole) _____
Date well completed _____ 19____
Application for plugging filed _____ 19____
Application for plugging approved _____ 19____
Plugging commenced 4-18-66 _____ 19____
Plugging completed 4-22-66 _____ 19____
Reason for abandonment of well or producing formation Depleted.

If a producing well is abandoned, date of last production _____ 19____
Was permission obtained from the Conservation Division or its agents before plugging was commenced? yes

Name of Conservation Agent who supervised plugging of this well Nichols
Producing formation _____ Depth to top _____ Bottom _____ Total Depth of Well 3988 Feet
Show depth and thickness of all water, oil and gas formations.

OIL, GAS OR WATER RECORDS

CASING RECORD

FORMATION	CONTENT	FROM	TO	SIZE	PUT IN	PULLED OUT
				8-5/8"	186'	None
				4-1/2"	3988'	1353'

Describe in detail the manner in which the well was plugged, indicating where the mud fluid was placed and the method or methods used in introducing it into the hole. If cement or other plugs were used, state the character of same and depth placed, from _____ feet to _____ feet for each plug set.

Checked hole to 3950', pushed plug to 3800', ran 50 gal. of sand and dumped 3 sacks of cement with dump bailer. Pulled 4 1/2" casing to 600' and circulated with 20 sacks of gel mud. Pulled 4 1/2" casing to 540' and pumped in 20 sacks of cement. Pulled 4 1/2" casing to 180' and pumped in 20 sacks of cement. Pulled balance of 4 1/2" casing and capped well with 10 sacks of cement.

Handwritten notes and stamps:
MAY 2 1966
5-2-66

PLUGGING COMPLETE.

(If additional description is necessary, use BACK of this sheet)
Name of Plugging Contractor KNIGHT CASING PULLING COMPANY
Address CHASE, KANSAS

STATE OF KANSAS, COUNTY OF RICE, ss.
Noel J. Knight (employee of owner) or (~~owner~~) of the above-described well, being first duly sworn on oath, says: That I have knowledge of the facts, statements, and matters herein contained and the log of the above-described well as filed and that the same are true and correct. So help me God.

(Signature) Noel J. Knight
Chase, Kansas
(Address)

SUBSCRIBED AND SWORN TO before me this 29th day of April, 1966

My commission expires May 20, 1968

Milton J. Volin
Notary Public.