


WELL PLUGGING RECORD

Give All Information Completely
Make Required Affidavit
Mail or Deliver Report to:
Conservation Division
State Corporation Commission
212 No. Market
Wichita, Kansas

NORTH

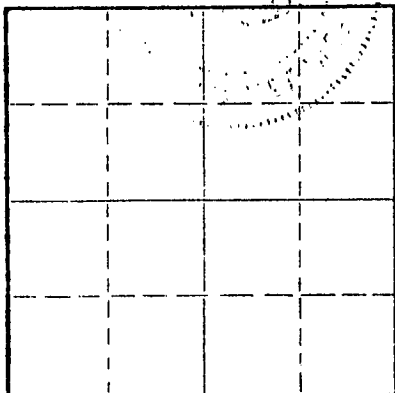

Locate well correctly on above
Section Plat

~~3368~~ Graham County, Sec. 14 Twp. 9 Rge. 24 (E) W (W)
SW NE SW

Location as "NE/CNW/SW" or footage from lines _____
Lease Owner Dom Pratt
Lease Name Nickelson Well No. 1
Office Address Hays, Kansas
Character of Well (completed as Oil, Gas or Dry Hole) _____
Date well completed _____ 19____
Application for plugging filed _____ 19____
Application for plugging approved _____ 19____
Plugging commenced 10/1/68 _____ 19____
Plugging completed 10/3/68 _____ 19____
Reason for abandonment of well or producing formation depleted.

If a producing well is abandoned, date of last production _____ 19____
Was permission obtained from the Conservation Division or its agents before plugging was commenced? yes

Name of Conservation Agent who supervised plugging of this well Nichols
Producing formation _____ Depth to top _____ Bottom _____ Total Depth of Well 4045 Feet
Show depth and thickness of all water, oil and gas formations.

OIL, GAS OR WATER RECORDS

CASING RECORD

FORMATION	CONTENT	FROM	TO	SIZE	PUT IN	PULLED OUT
				8-5/8	209'	none
				5 1/2"	4044'	986'

Describe in detail the manner in which the well was plugged, indicating where the mud fluid was placed and the method or methods used in introducing it into the hole. If cement or other plugs were used, state the character of same and depth placed, from _____ feet to _____ feet for each plug set.

Checked hole to 4015', ran sand to 3950' and ran 5 sacks of cement.
Shot pipe at 3387', loaded hole with water. Shot pipe at 2972', 2500',
1978', 1503', 1218', 1001', got loose and pulled 32 joints. Cut off
poorboy and welded on 8" collar. Pumped 15 sacks gel and 5 sacks of
hulls, pumped 100 sacks of cement, 12 sacks of gel and 20sacks of cement,
3 gel and 10 cement.

PLUGGING COMPLETE.

RECEIVED
STATE CORPORATION COMMISSION
OCT 9 - 1968 10-9-68
CONSERVATION DIVISION
Wichita, Kansas


(If additional description is necessary, use BACK of this sheet)
Name of Plugging Contractor KNIGHT CASING PULLING CO., INC.
Address CHASE, KANSAS

STATE OF KANSAS, COUNTY OF RICE, ss.
NOEL J. KNIGHT (employee of owner) or (owner or operator) of the above-described well, being first duly sworn on oath, says: That I have knowledge of the facts, statements, and matters herein contained and the log of the above-described well as filed and that the same are true and correct. So help me God.

(Signature) Noel Knight
CHASE, KANSAS
(Address)

SUBSCRIBED AND SWORN TO before me this 4th day of October, 19 68


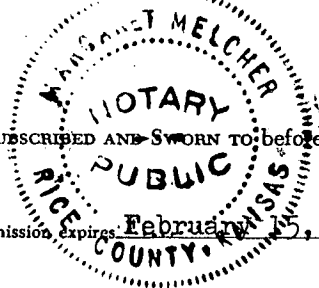

Margaret Melcher
Notary Public.