


STATE OF KANSAS
STATE CORPORATION COMMISSION

Give All Information Completely
Make Required Affidavit
Mail or Deliver Report to
Conservation Division
State Corporation Commission

P. O. Box 17027
Wichita, Kansas 67217
NORTH

WELL PLUGGING RECORD

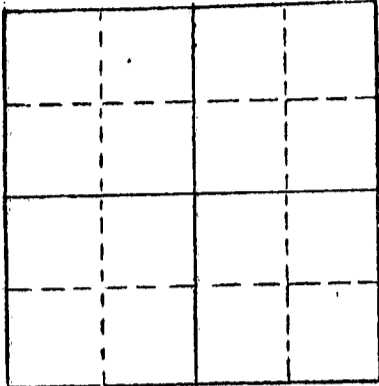

Locate well correctly on above
Section Plat

Graham County, Sec. 5 Twp. 9 Rge. 24 (E) (W) x
Location as "NE/CNW/SW" or footage from lines NE NE SE

Lease Owner Petroleum Management Inc. Well No. #17-1

Lease Name Holley Unit

Office Address 1515 Vickers KSB&T Bldg. Wichita, Kansas

Character of Well (completed as Oil, Gas or Dry Hole) _____

Date well completed _____ 19__

Application for plugging filed _____ 19__

Application for plugging approved _____ 19__

Plugging commenced 10-19-73 _____ 19__

Plugging completed 2-21-74 _____ 19__

Reason for abandonment of well or producing formation _____

If a producing well is abandoned, date of last production _____ 19__

Was permission obtained from the Conservation Division or its agents before plugging was commenced? _____

Name of Conservation Agent who supervised plugging of this well W. L. Nichols

Producing formation _____ Depth to top _____ Bottom _____ Total Depth of Well 4070' Feet

Show depth and thickness of all water, oil and gas formations.

OIL, GAS OR WATER RECORDS

CASING RECORD

FORMATION	CONTENT	FROM	TO	SIZE	PUT IN	PULLED OUT
				5 1/2"	4069'	1162.84'
				8 5/8"	232'	

Describe in detail the manner in which the well was plugged, indicating where the mud fluid was placed and the method or methods used in introducing it into the hole. If cement or other plugs were used, state the character of same and depth placed, from _____ feet to _____ feet for each plug set.

Made bottom hole plug back with sand to 3960'. Mixed and ran 5 sacks cement thru dump bailer.

Well plugged by Halliburton. Pumped plug to 2707'. 35 sacks cement on top.

RECEIVED
STATE CORPORATION COMMISSION
3-25-74
MAR 25 1974
CONSERVATION DIVISION
Wichita, Kansas

(If additional description is necessary, use BACK of this sheet)
Name of Plugging Contractor Southwest Casing Pulling Co.

Address Box 364 Great Bend, Kansas

STATE OF Kansas COUNTY OF Barton ss.


Southwest Casing Pulling Co. (employee of owner) or (owner or operator) of the above-described

being first duly sworn on oath, says: That I have knowledge of the facts, statements, and matters herein contained and the log of the above-described well as filed and that the same are true and correct. So help me God.

(Signature) W. C. Spencer Sec

Box 364 Great Bend, Kansas
(Address)

Sworn to before me this 25 day of March 19 74

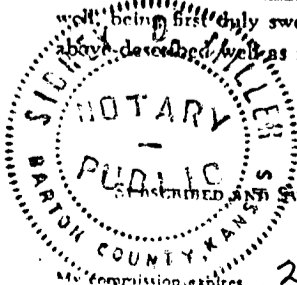

24 October 1976

Sidney D. Miller
Notary Public.