

STATE OF KANSAS  
STATE CORPORATION COMMISSION

Form CP-4

Give All Information Completely  
Make Required Affidavit  
Mail or Deliver Report to:  
Conservation Division  
State Corporation Commission  
212 No. Market  
Wichita, Kansas 67202

WELL PLUGGING RECORD

Graham County, Sec. 6 Twp. 9 Rge. 24 (E) (W) x

Location as "NE/CNW/SW" or footage from lines NE NE NW

Lease Owner Petroleum Management Inc.

Lease Name Holly Unit Tract #12 Well No. #2

Office Address Box 922, Great Bend, Kansas

Character of Well (completed as Oil, Gas or Dry Hole) \_\_\_\_\_

Date well completed \_\_\_\_\_ 19 \_\_\_\_\_

Application for plugging filed 1-6-72 19 \_\_\_\_\_

Application for plugging approved \_\_\_\_\_ 19 \_\_\_\_\_


Plugging commenced 1-15-72 19 \_\_\_\_\_

Plugging completed 1-18-72 19 \_\_\_\_\_

Reason for abandonment of well or producing formation \_\_\_\_\_

If a producing well is abandoned, date of last production \_\_\_\_\_ 19 \_\_\_\_\_

Was permission obtained from the Conservation Division or its agents before plugging was commenced? \_\_\_\_\_

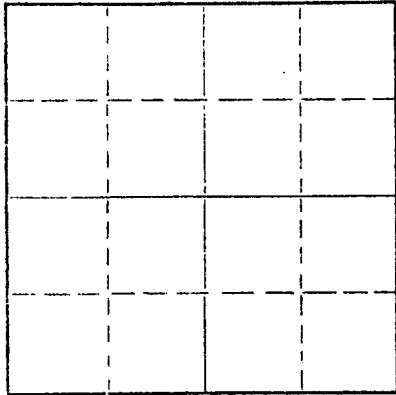

Locate well correctly on above Section Plat

Name of Conservation Agent who supervised plugging of this well W. L. Nichols

Producing formation \_\_\_\_\_ Depth to top \_\_\_\_\_ Bottom \_\_\_\_\_ Total Depth of Well 3978' Feet

Show depth and thickness of all water, oil and gas formations.

OIL, GAS OR WATER RECORDS

CASING RECORD

FORMATION	CONTENT	FROM	TO	SIZE	PUT IN	PULLED OUT
				5 1/2"	3972'	1121.53'
				8 5/8"	180	

Describe in detail the manner in which the well was plugged, indicating where the mud fluid was placed and the method or methods used in introducing it into the hole. If cement or other plugs were used, state the character of same and depth placed, from \_\_\_\_\_ feet to \_\_\_\_\_ feet for each plug set.

Made bottom hole plug back with sand to 3800'. Mixed and ran 5 sacks cement thru dump bailer.  
Squeezed hole with 5 sacks hulls - 10 sacks gel, 110 sacks cement, cement from 1225' to 900'. 17 sacks gel, gel from 900' to 220'. 30 sacks cement, cement from 220' to 145'. 3 sacks gel, gel from 145' to 25'. 10 sacks cement, cement from 25' to base of cellar.

RECEIVED  
STATE CORPORATION COMMISSION  
1-24-72  
JAN 24 1972  
CONSERVATION DIVISION  
Wichita, Kansas

(If additional description is necessary, use BACK of this sheet)

Name of Plugging Contractor Southwest Casing Pulling Co.

Address Box 364 Great Bend, Kansas


STATE OF Kansas COUNTY OF Barton, ss.

Southwest Casing Pulling Co. (employee of owner) or (owner or operator) of the above-described well, being first duly sworn on oath, says: That I have knowledge of the facts, statements, and matters herein contained and the log of the above-described well as filed and that the same are true and correct. So help me God.

(Signature) W. C. Spencer Sec.

Box 364 Great Bend, Kansas  
(Address)

SUBSCRIBED AND SWORN TO before me this 21 day of January, 1972

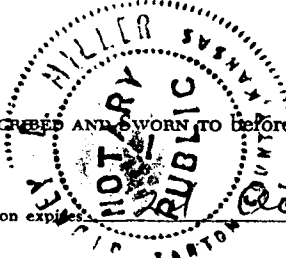

My commission expires October 1972

Sydney D. Miller  
Notary Public.