


STATE OF KANSAS
STATE CORPORATION COMMISSION

WELL PLUGGING RECORD

Give All Information Completely
Make Required Affidavit
Mail or Deliver Report to:
Conservation Division
State Corporation Commission
211 No. Broadway
Wichita, Kansas

NORTH

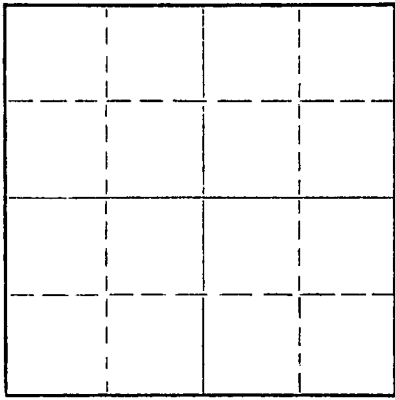

Locate well correctly on above
Section Plat

Graham County. Sec. 11 Twp. 9S Rge. 24 (E) W (W)
Location as "NE/CNWxSWx" or footage from lines. Center SW SW
Lease Owner J. E. Morris, Etal
Lease Name Rice Estate Well No. 1
Office Address Box 334, El Dorado, Kansas
Character of Well (completed as Oil, Gas or Dry Hole) Dry Hole
Date well completed June 3 1957
Application for plugging filed June 3 1957
Application for plugging approved " 19 "
Plugging commenced " 19 "
Plugging completed " 19 "
Reason for abandonment of well or producing formation Dry Hole

If a producing well is abandoned, date of last production _____ 19____
Was permission obtained from the Conservation Division or its agents before plugging was commenced? Yes

Name of Conservation Agent who supervised plugging of this well Eldon Petty, Box 326, Hays, Kansas
Producing formation None Depth to top _____ Bottom _____ Total Depth of Well 4085 Feet
Show depth and thickness of all water, oil and gas formations.

OIL, GAS OR WATER RECORDS

CASING RECORD

FORMATION	CONTENT	FROM	TO	SIZE	PUT IN	PULLED OUT
Surface Hole	Water	0	234	8 5/8"	228	None
See Attached Log						

Describe in detail the manner in which the well was plugged, indicating where the mud fluid was placed and the method or methods used in introducing it into the hole. If cement or other plugs were used, state the character of same and depth placed, from _____ feet to _____ feet for each plug set.

Filled with mud from total depth to 750': Put 25 Sacks of cement on bridge plug
@ 750' through Drill Pipe: Filled with mud to 40': Set Bridge Plug @ 40' and
filled to surface with 10 Sacks of cement.

RECEIVED
STATE CORP
6-20-57

(If additional description is necessary, use BACK of this sheet)
Name of Plugging Contractor Rex & Morris Drilling Company
Address Box 334, El Dorado, Kansas

STATE OF Kansas, COUNTY OF Butler, ss.
C. E. McClure (employee of owner) or (owner or operator) of the above-described well, being first duly sworn on oath, says: That I have knowledge of the facts, statements, and matters herein contained and the log of the above-described well as filed and that the same are true and correct. So help me God.

(Signature) C. E. McClure
Box 334, El Dorado, Kansas
(Address)

SUBSCRIBED AND SWORN TO before me this 19th day of June 19 57

My commission expires July 23, 1960
Winifred E. Cruitt
Winifred E. Cruitt Notary Public.

PLUGGING
FILED SEC 11 T 9 R 24 W
BOOK PAGE 18 LINE 18

Elevation 483 R. B.
48. E. F.

RICE ESTATE # 1

J. E. MORRIS AND C. R. A.

Total Depth	- 4085	Location	- C-SW-SW
Contractor	- Rex & Morris Drilling Co.	Section	- 11-9S-24W
Commenced	- 5-26-57	Graham County, Kansas	
Completed	- 6- 3-57		
Initial Production	- D & A		

Casing Record:
8 5/8" @ 34' w/ 130 sacks

FORMATION	DEPTH
Surface Hole	034
Shale	1205
Shale & Shells	1700
Sand & Red Beds	1900
Shale	1960
Red Beds	2130
Anhydrite	2180
Shale & Shells	2440
Lime & Shale	2910
Shale & Lime	3110
Lime & Shale	3810
Lime T.D.	4085

Schlumberger

I hereby certify the foregoing statements are true and correct to the best of my knowledge and belief.

Rex & Morris Drilling Company
 By _____
 Title Geologist

STATE OF KANSAS)
) SS.
 COUNTY OF BUILER)

Subscribed and sworn to before me, a Notary Public, this 19th day of June 1957.

Winifred E. Crum
 Notary Public

My commission expires:
July 13, 1960

WINIFRED E. CRUM

166
 11-9 24W
 18 10