


15-065-20654-0000

STATE OF KANSAS  
STATE CORPORATION COMMISSION

Form CP-4

Give All Information Completely  
Make Required Affidavit  
Mail or Deliver Report to:  
Conservation Division  
State Corporation Commission  
P. O. Box 17027  
Wichita, Kansas 67217  
NORTH

WELL PLUGGING RECORD

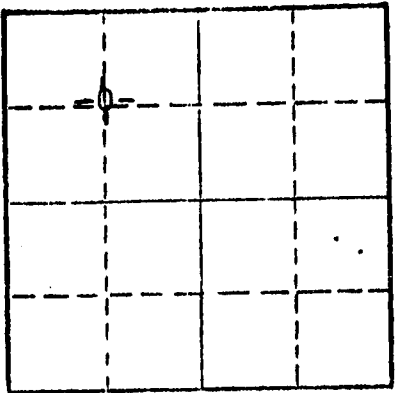

Locate well correctly on above Section Plat

GRAHAM County. Sec. 33 Twp. 9S Rge. (E) 24 (W)  
Location as "NE/CNWKSWK" or footage from lines C NW/4  
Lease Owner Delta Western Company & George A. Reed  
Lease Name Critchfield Well No. 4  
Office Address 806 First National Center, Oklahoma City, Okla.  
Character of Well (completed as Oil, Gas or Dry Hole) Dry Hole  
Date well completed March 5 1974  
Application for plugging filed March 5 1974  
Application for plugging approved March 5 1974  
Plugging commenced March 5 1974  
Plugging completed March 5 1974  
Reason for abandonment of well or producing formation Too low structurally  
If a producing well is abandoned, date of last production 19  
Was permission obtained from the Conservation Division or its agents before plugging was commenced?  
Name of Conservation Agent who supervised plugging of this well W. L. Nichols, Morland, Kansas  
Producing formation Depth to top Bottom Total Depth of Well 4125 Feet  
Show depth and thickness of all water, oil and gas formations.

OIL, GAS OR WATER RECORDS

CASING RECORD

FORMATION	CONTENT	FROM	TO	SIZE	PUT IN	PULLED OUT
				8 5/8"	299.35'	None

Describe in detail the manner in which the well was plugged, indicating where the mud fluid was placed and the method or methods used in introducing it into the hole. If cement or other plugs were used, state the character of same and depth placed, from feet to feet for each plug set.

Filled with heavy mud to 1250'. Set plug. Put in 110 sacks cement. Filled with heavy mud to 310'. Set plug. Put in 30 sacks cement. Filled with heavy mud to 40'. Set plug. Filled top with 10 sacks cement.

RECEIVED  
STATE CORPORATION COMMISSION  
3-15-74  
MAR 15 1974  
CONSERVATION DIVISION  
Wichita, Kansas

(If additional description is necessary, use BACK of this sheet)  
Name of Plugging Contractor C-G DRILLING CO.  
Address 1107 Union National Building, Wichita, Kansas 67202

STATE OF KANSAS, COUNTY OF SEDGWICK, ss.  
Jay H. Galloway (employee of owner) or (owner or operator) of the above-described well, being first duly sworn on oath, says: That I have knowledge of the facts, statements, and matters herein contained and the log of the above-described well as filed and that the same are true and correct. So help me God.

(Signature) Jay H. Galloway 1107 Union Natl Bldg.  
(Address)

Sworn to before me this 5th day of March, 1974



December 7, 1975

Phyllis Buchanan  
Notary Public.