

15-065-00762-0000

STATE OF KANSAS  
STATE CORPORATION COMMISSION


WELL PLUGGING RECORD

Give All Information Completely  
Make Required Affidavit  
Mail or Deliver Report to:  
Conservation Division  
State Corporation Commission  
800 Bittling Building  
Wichita, Kansas

GRAHAM County, Sec. 1 Twp. 9 Rge. 25N (E) (W)

Location as "NE/CNWSW" or footage from lines SW SW NE  
Lease Owner Petroleum Management, Inc. for Prime Drlg. Co.  
Lease Name CLARK Well No. 1  
Office Address 810 Central Bldg., Wichita 2, Kansas  
Character of Well (completed as Oil, Gas or Dry Hole) Dry Hole  
Date well completed 7-4-19 55  
Application for plugging filed 7-8-19 55  
Application for plugging approved 7-9-19 55  
Plugging commenced 7-10 19 55  
Plugging completed 7-14 19 55  
Reason for abandonment of well or producing formation Non Commercial

NORTH

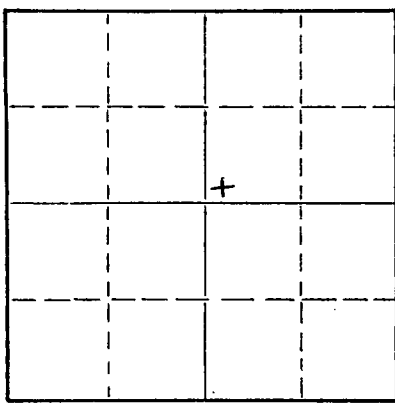

Locate well correctly on above  
Section Plat

If a producing well is abandoned, date of last production NONE 19\_\_  
Was permission obtained from the Conservation Division or its agents before plugging was commenced? Yes

Name of Conservation Agent who supervised plugging of this well Merle Reeves  
Producing formation \_\_\_\_\_ Depth to top \_\_\_\_\_ Bottom \_\_\_\_\_ Total Depth of Well 4065 Feet  
Show depth and thickness of all water, oil and gas formations.

OIL, GAS OR WATER RECORDS El: G. L. 2475 CASING RECORD

FORMATION	CONTENT	FROM	TOP	SIZE	PUT IN	PULLED OUT
Heebner			3774'	8 5/8"	250'	None
Toronto			3799'	5 1/2"	4060'	3306
Lansing			3813'			
Cement inside casing not drilled out. Top at 4024'. Casing perforated at 3816'						

Describe in detail the manner in which the well was plugged, indicating where the mud fluid was placed and the method or methods used in introducing it into the hole. If cement or other plugs were used, state the character of same and depth placed, from \_\_\_\_\_ feet to \_\_\_\_\_ feet for each plug set.

Set a plug at 3750' and ran 4 sacks of cement. Mudded the hole to 260', set a 10' rock bridge and ran 15 sacks of cement at 250'. Mudded the hole to 35' and ran 10 sacks cement on top.

7-26-55  
CONSERVATION DIVISION

(If additional description is necessary, use BACK of this sheet)  
Name of Plugging Contractor West Supply Company, Chase, Kansas  
Address \_\_\_\_\_

STATE OF KANSAS, COUNTY OF SEDGWICK, ss.  
John W. Ritchey (employee of owner) or (owner or operator) of the above-described well, being first duly sworn on oath, says: That I have knowledge of the facts, statements, and matters herein contained and the log of the above-described well as filed and that the same are true and correct. So help me God.

(Signature) John W. Ritchey  
810 Central Building, Wichita 2, Kansas  
(Address)

SUBSCRIBED AND SWORN TO before me this 20th day of July, 1955

My commission expires May 21, 1956.

Eva Spencer  
Eva Spencer Notary Public.

**PLUGGING**  
FILE SEC 1 T 9 R 25N  
BOOK PAGE 132 LINE 33

ROTARY DRILLING LOG

OPERATOR: Prime Drilling Company, Et al  
 Clark #1  
 SW SW NE Sec. 1-9S-25W  
 Graham County, Kansas

CONTRACTOR: Prime Drilling Company  
 COMM: 6-9-55  
 COMP: 6-21-55

<u>Formation</u>	
Sand & top soil	150
Shale	250
Gray Shale Chalk	1010
Shale & Sand	1075
Shale, Shells & Sand	1600
Lime & Shale	2100
Red Bed, Shale & Shells	2190
Anhydrite	2235
Shale & Lime	3685
Lime	3730
Lime & Shale	3870
Lime	4040
Lime & Shale	4065
Rotary Total Depth	4065

Remarks  
 Set 8-5/8" surface casing at 250'  
 cemented with 175 sacks common  
 cement with 2% C.C.

Set 5-1/2" casing at 4160' with  
 100 sacks Farnix.

We certify that the above log is  
 true and correct to the best of  
 our knowledge and belief.

PRIME DRILLING COMPANY

*R. R. McNicol*

R. R. McNicol

RECORDED  
 STATE OF KANSAS  
 COUNTY OF GRAHAM

**PLUGGING**  
 FILE SEC 1 T 9 R 25W  
 BOOK PAGE 122 LINE 22