

15-065-02134-0000


STATE OF KANSAS
STATE CORPORATION COMMISSION

WELL PLUGGING RECORD

Give All Information Completely
Make Required Affidavit
Mail or Deliver Report to:
Conservation Division
State Corporation Commission
800 Bittling Building
Wichita, Kansas

Graham County, Sec. 1 Twp. 9 Rge. (E) 25 (W)

Location as "NE/CNW $\frac{1}{4}$ SW $\frac{1}{4}$ " or footage from lines NW NW SW $\frac{1}{4}$
Lease Owner M.B. Armer
Lease Name Keith Well No. 1
Office Address 710 Petroleum Building Wichita, Kansas
Character of Well (completed as Oil, Gas or Dry Hole) dry
Date well completed Dec. 14 19 51
Application for plugging filed Jan. 17 19 52
Application for plugging approved Jan. 17 19 52
Plugging commenced Jan. 17 19 52
Plugging completed Jan. 22 19 52
Reason for abandonment of well or producing formation.....

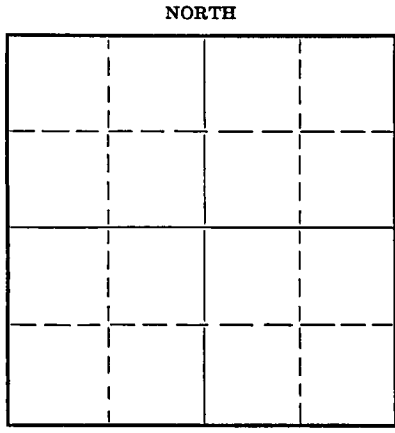

Locate well correctly on above
Section Plat

If a producing well is abandoned, date of last production..... 19.....
Was permission obtained from the Conservation Division or its agents before plugging was commenced?..... Yes

Name of Conservation Agent who supervised plugging of this well Eldon Petty
Producing formation..... Depth to top..... Bottom..... Total Depth of Well ~~1119~~ 4059 Feet
Show depth and thickness of all water, oil and gas formations.

OIL, GAS OR WATER RECORDS

21
KCL CASING RECORD

Formation	Content	From	To	Size	Put In	Pulled Out
				10 3/4	246	none
				7	4058	1688

Describe in detail the manner in which the well was plugged, indicating where the mud fluid was placed and the method or methods used in introducing it into the hole. If cement or other plugs were used, state the character of same and depth placed, from..... feet to..... feet for each plug set.

Plugged back with crushed rock to 4030 ft., dumped 5 sacks cement with dump bailer. Top of cement 4008 ft. Mudded hole to 200 ft., set rock bridge, dumped 20 sacks cement. Top of cement 160 ft. Mudded hole to 20 ft., set rock bridge, dumped 10 sacks for cap.

2-2-52

(If additional description is necessary, use BACK of this sheet)

Name of Plugging Contractor Miller Casing Pulling Company
Address Great Bend, Kansas

STATE OF Kansas, COUNTY OF Sedgwick, ss.
L. C. Sponenberg (employee of owner) or (owner or operator) of the above-described well, being first duly sworn on oath, says: That I have knowledge of the facts, statements, and matters herein contained and the log of the above-described well as filed and that the same are true and correct. So help me God.

(Signature) L. C. Sponenberg

(Address)

SUBSCRIBED AND SWORN TO before me this 31 day of January, 19 52

Hazel Walter
Notary Public.

My commission expires September 17, 1955

23-8390-s 6-51-20M

PLUGGING
BOOK PAGE 141-2

DRILLING LOG

Company -- Siegel, Koplin & Armer
 Contractor -- Woody Speer
 Drilling commenced -- 11-6-51
 Drilling completed -- 11-22-51
 Elevation -- 2538 D.F. 2541 R.B.

Farm -- Keith #1
 Location -- NWc NW SW
 1-9-25W
 Graham County, Kansas
 Casing Record -- 10-3/4" OD @ 243'
 w/ 200 sacks cement
 7" OD @ 4,052 w/50
 sacks cement

(Figures below indicate bottom)


Soil, clay and shells	40
Sand	195
Shale	246
Shale and shells	1175
Sand and shale	1580
Shale and lime	1650
Shale and shells	1900
Red bed and shells	2280
Lime and shale	2530
Shale shells	2610
Shale and lime	2790
Blue shale	2963
Lime and shale	2940
Sandy lime and shale	3035
Shale and lime	3135
Lime	3145
Lime and shale	3195
Lime	3255
Lime and shale	3475
Lime	3530
Lime and shale	3595
Lime	3780
Lime and shale	3855
Lime	4000
Lime and shale	4040
Lime	4061
R.T.D.	4061
R.T.D. Correction	4058
#1 Drill Stem Test	4016-4061
Open 1 hr. recovered 10' mud	
No bottom hole pressure	

FORMATION TOPS (R.B. Measurement)

Heebner	3822
Toronto	3845
Lansing K.C.	3861
Marmaton	4029

I hereby certify that this is a true and correct log of the above described well as shown by the drilling reports.

WOODY SPEER

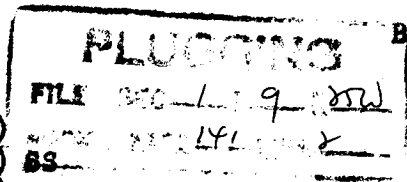

By Woody Speer

STATE OF KANSAS }
 COUNTY OF SEDGWICK }

Subscribed and sworn to before me, a notary public, in and for said County and State this 27-th day of November, 1951.

My commission expires Sept. 17, 1955

My commission expires _____

Harold Walton
 Notary Public