


STATE OF KANSAS  
STATE CORPORATION COMMISSION

WELL PLUGGING RECORD

Give All Information Completely  
Make Required Affidavit  
Mail or Deliver Report to:  
Conservation Division  
State Corporation Commission  
806 Bitting Building  
Wichita, Kansas

NORTH

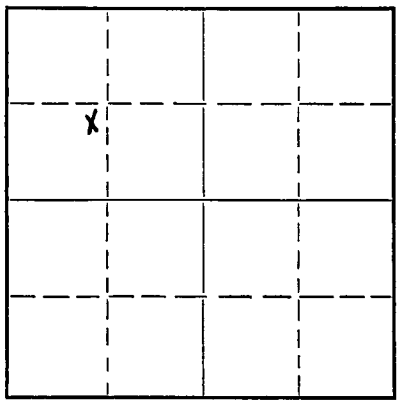

Locate well correctly on above  
Section Plat

Graham County. Sec. 1 Twp. 9 Rge. 25 (E) W (W)  
Location as "NE/CNW $\frac{1}{4}$ SW $\frac{1}{4}$ " or footage from lines NE/1 SW/1 NW/1  
Lease Owner Prime Drilling Company & Milo Siegel  
Lease Name Minium Well No. 2  
Office Address 1516 Apco Tower, Oklahoma City, Okla.  
Character of Well (completed as Oil, Gas or Dry Hole) Dry Hole  
Date well completed 1-12-52  
Application for plugging filed 1-12-52  
Application for plugging approved 1-12-52  
Plugging commenced 1-12-52  
Plugging completed 1-12-52  
Reason for abandonment of well or producing formation \_\_\_\_\_

If a producing well is abandoned, date of last production \_\_\_\_\_ 19\_\_\_\_  
Was permission obtained from the Conservation Division or its agents before plugging was commenced? Yes

Name of Conservation Agent who supervised plugging of this well Eldon Petty, Hayes, Kansas  
Producing formation \_\_\_\_\_ Depth to top \_\_\_\_\_ Bottom \_\_\_\_\_ Total Depth of Well 4015 Feet  
Show depth and thickness of all water, oil and gas formations.

OIL, GAS OR WATER RECORDS

CASING RECORD

Formation	Content	From	To	Size	Put In	Pulled Out
				8-5/8	260	None

Describe in detail the manner in which the well was plugged, indicating where the mud fluid was placed and the method or methods used in introducing it into the hole. If cement or other plugs were used, state the character of same and depth placed, from \_\_\_\_\_ feet to \_\_\_\_\_ feet for each plug set.

Filled Hole with heavy drilling mud to 240', set plug, and cemented with 15 sacks cement. Filled hole to 40' with heavy drilling mud, set plug and cemented to bottom of cellar with 10 sacks cement.

1-26-52

(If additional description is necessary, use BACK of this sheet)

Name of Plugging Contractor Prime Drilling Company  
Address 1516 Apco Tower, Oklahoma City, Oklahoma


STATE OF Oklahoma, COUNTY OF Oklahoma, SS.  
L. J. Kruse (employee of owner) or (owner or operator) of the above-described well,

being first duly sworn on oath, says: That I have knowledge of the facts, statements, and matters herein contained and the log of the above-described well as filed and that the same are true and correct. So help me God.

(Signature) L. J. Kruse  
Oklahoma City, Oklahoma  
(Address)

SUBSCRIBED AND SWORN to before me this 24th day of January, 19 52  
Lillian Wright  
Notary Public.

My commission expires October 24, 1955

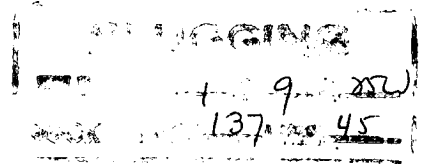

PRIME DRILLING COMPANY & MILO SIEGEL

MINIUM # 2 WELL

NE/4 SW/4 NW/4  
 Sec. 1-9S-25W  
Graham County, Kans.

<u>FORMATION</u>	<u>FROM</u>	<u>TO</u>	<u>REMARKS</u>
Surface Clay & Sand	0	125	
Sand	125	195	8-5/8" C.S.A. @ 255'. Cemented
Shale & Shell	195	620	with 130 Sacks Cement
Chalk Rock & Shale	620	680	
Shale & Shell	680	1090	
Shale Shell & Sand	1090	1485	
Shale Shells Pyrite	1485	1520	
Shale & Shells	1520	1610	
Shale Shells Red Bed	1610	1750	
Shale & Sand	1750	1890	
Shale & Shells	1890	2195	
Anhydrite	2195	2230	
Red Bed Shale & Shell	2230	2460	
Red Bed Shale Iron Pyrite	2460	2515	
Red Bed Shale Shells	2515	2545	
Shale & Lime	2545	3045	
Red Bed Lime & Shale	3045	3070	
Shale & Lime	3070	3660	
Lime & Shale	3660	3870	
Lime	3870	4015	
Total Depth		4015'	

I hereby certify the foregoing to be a true and accurate Driller's Log of the formations encountered in the above well.

PRIME DRILLING COMPANY

By: L. J. Kruse  
 L. J. Kruse  
 Secretary

Subscribed and sworn to before me this 25th day of January, 1952.

Lillian W. ...  
 Notary Public  
 JAN 26 1952  
 COMMISSION EXPIRES ...

My Commission Expires: October 24, 1955

