


STATE OF KANSAS
STATE CORPORATION COMMISSION

WELL PLUGGING RECORD

Give All Information Completely
Make Required Affidavit
Mail or Deliver Report to:
Conservation Division
State Corporation Commission
800 Bittling Building
Wichita, Kansas

GRAHAM County. Sec. 1 Twp. 9 Rge. 25 (E) (W)
Location as "NE/CNW/SE/SW" or footage from lines NE SW NW
Lease Owner PETROLEUM MANAGEMENT, INC., FOR PRIME DRILLING COMPANY
Lease Name MINIUM Well No. 2
Office Address 810 Central Building, Wichita 2, Kansas
Character of Well (completed as Oil, Gas or Dry Hole) Dry Hole
Date well completed 1-12-19 52
Application for plugging filed 7-17 19 55
Application for plugging approved 7-17 19 55
Plugging commenced 7-17 19 55
Plugging completed 7-17 19 55
Reason for abandonment of well or producing formation Dry Hole
If a producing well is abandoned, date of last production 19
Was permission obtained from the Conservation Division or its agents before plugging was commenced? Yes

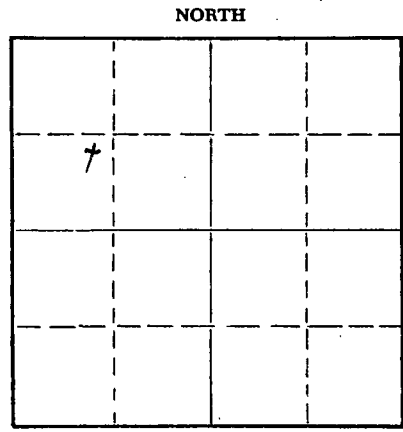

Locate well correctly on above Section Plat

Name of Conservation Agent who supervised plugging of this well _____
Producing formation _____ Depth to top _____ Bottom _____ Total Depth of Well 4 5055' Feet
Show depth and thickness of all water, oil and gas formations. PTCC

OIL, GAS OR WATER RECORDS

CASING RECORD

FORMATION	CONTENT	FROM	TO	SIZE	PUT IN.	PULLED OUT
				8 5/8	260'	NONE

Describe in detail the manner in which the well was plugged, indicating where the mud fluid was placed and the method or methods used in introducing it into the hole. If cement or other plugs were used, state the character of same and depth placed, from _____ feet to _____ feet for each plug set.

Mud from bottom to 250', set Halliburton plug, 1/2 sack hulls and 15 sacks cement and mud to 40', set another Halliburton plug and 1/2 sack hulls. Filled to top with 10 sacks cement.

NOTE:

This is an old dry hole washed down. Tests failed, so well was re-plugged and abandoned as a failure.

(If additional description is necessary, use BACK of this sheet)

Name of Plugging Contractor Plugged by Prime Drilling Company, rotary
Address _____


STATE OF KANSAS, COUNTY OF GRAHAM, ss.
John W. Ritchey (employee of owner) or (~~owner or operator~~) of the above-described well, being first duly sworn on oath, says: That I have knowledge of the facts, statements, and matters herein contained and the log of the above-described well as filed and that the same are true and correct. So help me God.

(Signature) John W. Ritchey
810 Central Bldg., Wichita 2, Kansas
(Address)

SUBSCRIBED AND SWORN TO before me this 29th day of July, 1955

My commission expires May - 21, 1956.

Eva Spencer
Eva Spencer
Notary Public.

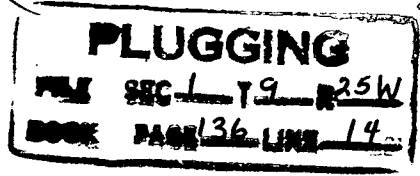

7-30-55

ROTARY DRILLING LOG

OPERATOR: Petroleum Management	CONTRACTOR: Prime Drilling Company
Minium (Wash Down) #2	COMM: 7/14/55
NE SW NW Sec. 1-9S-25W	COMP: 7/17/55
Graham County, Kansas	

Formations:

Surface Clay & Sand	125
Sand	195
Shale & Shells	620
Chalk Rock & Shale	680
Shale & Shell	1090
Shale Shell & Sand	1485
Shale Shells Pyrite	1520
Shale & Shells	1610
Shale, Shells Red Bed	1750
Shale & Sand	1890
Shale & Shells	2195
Anhydrite	2230
Red Bed Shale & Shells	2460
Red Bed Shale Iron Pyrite	2515
Red Bed Shale Shells	2545
Shale & Lime	3045
Red Bed Lime & Shale	3070
Shale & Lime	3660
Lime & Shale	3870
Lime	4015
Shale	4035
Shale & Lime	4055
Total Depth	4055

We certify that the above log is true and correct to the best of our knowledge and belief.

PRIME DRILLING COMPANY

R. R. McNicol
R. R. McNicol

