


STATE OF KANSAS
STATE CORPORATION COMMISSION
CONSERVATION DIVISION
P. O. BOX 17027
WICHITA, KANSAS 67217

WELL PLUGGING RECORD

Graham County, Sec 1 Twp. 9 Rge (E) 25 (W)

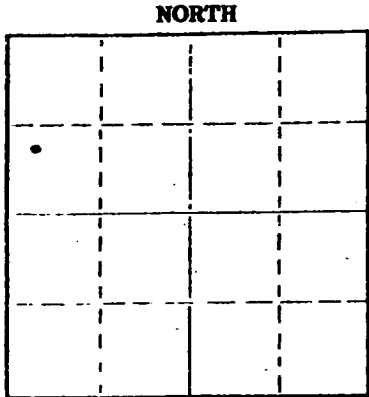

Locate well correctly on above Section Plot

Location as "NE/CNWKSW" or footage from lines NW SW NW
Lease Owner Thornton E. Anderson
Lease Name Minium "A"
Office Address Suite 746 - 300 W. Douglas, Wichita, Kansas
Character of Well (completed as Oil, Gas or Dry Hole) oil
Date well completed June 19 19 61
Application for plugging filed December 4 19 74
Application for plugging approved 19
Plugging commenced December 6 19 74
Plugging completed December 9 19 74
Reason for abandonment of well or producing formation depleted

If a producing well is abandoned, date of last production 19
Was permission obtained from the Conservation Division or its agents before plugging was commenced? yes

Name of Conservation Agent who supervised plugging of this well W. L. Nichols
Producing formation _____ Depth to top _____ Bottom _____ Total Depth of Well 4080 Feet
Show depth and thickness of all water, oil and gas formations.

OIL, GAS OR WATER RECORDS

CASING RECORD

| FORMATION | CONTENT | FROM | TO | SIZE | PUT IN | PULLED OUT |
|-----------|---------|------|-------|--------|--------|------------|
| | | | 189' | 8 5/8" | 189' | none |
| | | | 4079' | 5 1/2" | 4079' | 1420.23 |
| | | | | | | |
| | | | | | | |
| | | | | | | |
| | | | | | | |
| | | | | | | |

Describe in detail the manner in which the well was plugged, indicating where the mud fluid was placed and the method or methods used in introducing it into the hole. If cement or other plugs were used, state the character of same and depth placed, from _____ feet to _____ feet for each plug set.

Sanded back to 3900' and dumped 5 sacks of cement.
Plugged well pumping in 1 sack of hulls, 35 sacks of gel and 120 sacks of cement.

RECEIVED
STATE CORPORATION COMMISSION
DEC 13 1974 12-13-74
CONSERVATION DIVISION
Wichita, Kansas

Name of Plugging Contractor PIPE PULLERS, INC.
Address Box 128, Ellinwood, Kansas 67526

STATE OF KANSAS COUNTY OF BARTON ss.
Evelyn Roth

(employee of owner) or (owner or operator) of the above-described well, being first duly sworn on oath, says: That I have knowledge of the facts, statements, and matters herein contained and the log of the above-described well as filed and that the same are true and correct. So help me God.

(Signature) Evelyn Roth
Ellinwood, Kansas (Address)

Subscribed and sworn to before me this 12th day of December 19 74

My commission expires
JENNY KASSELMAN
NOTARY PUBLIC
BARTON COUNTY, KANSAS
MY COMM. EXP. JULY 16, 1978

Jenny Kasselmann
Notary Public.

WELL LOG BUREAU—KANSAS GEOLOGICAL SOCIETY
508 East Murdock, Wichita, Kansas

15-065-01627-0000


COPY

Company- PRIME DRILLING CO.
Farm- Minium "A" No. 3

SEC. 1 T. 9 R.25W
NW SW NW

Total Depth. 4080'
Comm. 6-8-61 Comp. 6-19-61
Shot or Treated.
Contractor. Prime Drig.
Issued. 9-30-61

County Graham
KANSAS

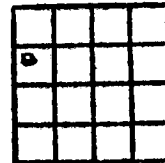

CASING:
8 5/8" 189' cem w/175 sx.
5 1/2" 4079' cem w/125 sx. & 25 gal. Latex

Elevation. 2514'

Production. 90 BOPD

Figures Indicate Bottom of Formations.

| | |
|----------------|----------|
| sand & clay | 189 |
| shale & shells | 1800 |
| shale & sand | 2200 |
| shale | 2230 |
| Anhydrite | 2275 |
| shale & shells | 2380 |
| shale & lime | 2545 |
| shale | 2665 |
| lime & shale | 2840 |
| shale & lime | 2920 |
| lime & shale | 3820 |
| lime | 4016 |
| lime & shale | 4080 RTD |
| Total Depth | |

| | |
|------------------|------|
| TOPS: SCOUT | |
| Topeka | 3574 |
| Heebner | 3790 |
| Toronto | 3814 |
| Lansing | 3830 |
| Base Kansas City | 4052 |

RECEIVED
STATE CORPORATION COMMISSION
DEC 9 1974
CONSERVATION DIVISION
Wichita, Kansas