


WELL PLUGGING RECORD

Give All Information Completely
Make Required Affidavit
Mail or Deliver Report to:
Conservation Division
State Corporation Commission
800 Biting Building
Wichita, Kansas

Ellis County. Sec. 32 Twp. 11 Rge. 20 ~~EX~~ (W)
Location as "NE/CNW $\frac{1}{4}$ SW $\frac{1}{4}$ " or footage from lines NW NW SW
Lease Owner SOHIO PETROLEUM COMPANY
Lease Name Keagy Well No. 1
Office Address Russell, Kansas
Character of Well (completed as Oil, Gas or Dry Hole) Dry
Date well completed 8-17-49 19
Application for plugging filed 8-17-49 19
Application for plugging approved 8-19-49 19
Plugging commenced 8-18-49 19
Plugging completed 8-18-49 19
Reason for abandonment of well or producing formation Dry

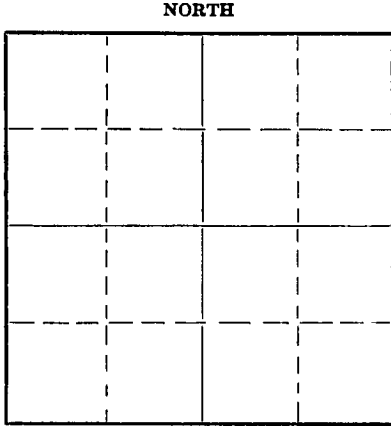

Locate well correctly on above Section Plat

If a producing well is abandoned, date of last production 19
Was permission obtained from the Conservation Division or its agents before plugging was commenced? Yes

Name of Conservation Agent who supervised plugging of this well C. D. Stough
Producing formation Depth to top Bottom Total Depth of Well 3900 Feet
Show depth and thickness of all water, oil and gas formations.

OIL, GAS OR WATER RECORDS

CASING RECORD

Formation	Content	From	To	Size	Put In	Pulled Out

Describe in detail the manner in which the well was plugged, indicating where the mud fluid was placed and the method or methods used in introducing it into the hole. If cement or other plugs were used, state the character of same and depth placed, from feet to feet for each plug set.

Gun pits and mix mud as heavy as possible; lay down all of drill pipe except 250'; Push plug to 250' with drill pipe, mix and displace through drill pipe 15 sacks of cement. Pull drill pipe and pump heavy mud to within 30' of the bottom of the cellar. Push plug to top of mud; mix 10 sacks of cement and plug to bottom of cellar.

(If additional description is necessary, use BACK of this sheet)

Correspondence regarding this well should be addressed to
Address


STATE OF KANSAS, COUNTY OF RUSSELL, ss.
J. H. BOND (employee of owner) ~~of the above-described well~~
being first duly sworn on oath, says: That I have knowledge of the facts, statements, and matters herein contained and the log of the above-described well as filed and that the same are true and correct. So help me God.

(Signature) J. H. Bond
Box 671, Russell, Kansas (Address)

SUBSCRIBED AND SWORN to before me this 23 day of August, 1949

My commission expires July 2, 1953
Russell Miller Notary Public.

8-25-1949

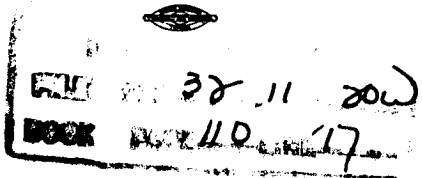

15-051-00690-00-00
CONTRACTOR'S VERIFIED LOG

Operator Sohio Petroleum Company Farm Name Keagy Well No. 1
 Location Northwest Northwest Southwest Section 32-11-20W
 Pool Name _____ County Ellis State Kansas
 Commencement Date 8-2-49 Completion Date 8-17-49

LOG OF WELL

Depth		Formation	Deviation from Vertical (Degrees)	Remarks
From	To			
0	20	Sand Clay		
20	237	Shale Shells		
227	750	Sand Shells		
750	1300	Sand Shale Shells		
1300	1620	Sandy Shale		
1620	1665	Anhydrite		
1665	2010	Lime Shale		
2010	2165	Shale Shells Some Salt		
2165	2560	Lime Shale		
2560	2615	Sticky Shale		
2615	2630	Lime		
2630	3215	Lime Shale		
3215	3260	Shale		
3260	3355	Lime Shale		
3355	3395	Lime		
3395	3425	Lime Shale		
3425	3730	Lime		
3730	3770	Lime Shale		
3770	3900	Lime		
3900		Total Depth		

9-17-1949

PLUGGING
 BOOK PAGE 10 LINE 17

