


Give All Information Completely
Make Required Affidavit
Mail or Deliver Report to:
Conservation Division
State Corporation Commission
800 Bittling Building
Wichita, Kansas

WELL PLUGGING RECORD

NORTH

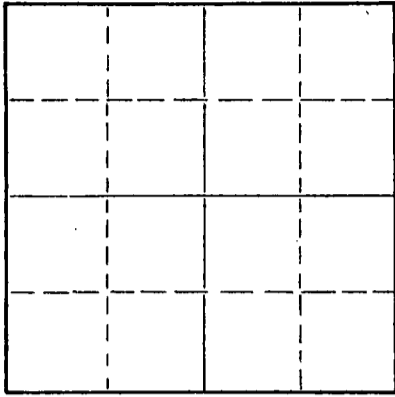

Locate well correctly on above
Section Plat

Ellis County, Sec. 31 Twp. 11 Rge. 20 (SE) II (W)
Location as "NE/CNW/SE/SW" or footage from lines SE/1, SE/1, S/1
Lease Owner Transit Corporation
Lease Name Homburg Well No. 1
Office Address 1516 Liberty Bank Bldg., Okla. City, Okla.
Character of Well (completed as Oil, Gas or Dry Hole) Dry Hole
Date well completed 7-19 1954
Application for plugging filed 7-19 1954
Application for plugging approved 7-19 1954
Plugging commenced 7-19 1954
Plugging completed 7-19 1954
Reason for abandonment of well or producing formation _____

If a producing well is abandoned, date of last production _____ 19____
Was permission obtained from the Conservation Division or its agents before plugging was commenced? Yes

Name of Conservation Agent who supervised plugging of this well Eldon Petty, Hays, Kansas
Producing formation _____ Depth to top _____ Bottom _____ Total Depth of Well 3965 Feet
Show depth and thickness of all water, oil and gas formations.

OIL, GAS OR WATER RECORDS

CASING RECORD

FORMATION	CONTENT	FROM	TO	SIZE	PUT IN	PULLED OUT
				8-5/8	191'	None

Describe in detail the manner in which the well was plugged, indicating where the mud fluid was placed and the method or methods used in introducing it into the hole. If cement or other plugs were used, state the character of same and depth placed, from _____ feet to _____ feet for each plug set.

Filled hole to 180' with heavy drilling mud, set plug and cemented with 15 sacks cement.
Filled hole to 38' with heavy drilling mud, set plug and cemented to bottom of cellar
with 10 sacks of cement.

STATE OF OKLAHOMA
7-24-1954

(If additional description is necessary, use BACK of this sheet)

Name of Plugging Contractor Transit Corporation
Address 1516 Liberty Bank Bldg., Oklahoma City, Okla.


STATE OF Oklahoma, COUNTY OF Oklahoma, ss.
C. W. Dodson (employee of owner) or (owner/operator) of the above-described well, being first duly sworn on oath, says: That I have knowledge of the facts, statements, and matters herein contained and the log of the above-described well as filed and that the same are true and correct. So help me God.

(Signature) C. W. Dodson
Oklahoma City, Okla. (Address)

SUBSCRIBED AND SWORN TO before me this 22nd day of July, 19 54

My commission expires February 14, 1957

Emelya Culver
Notary Public.

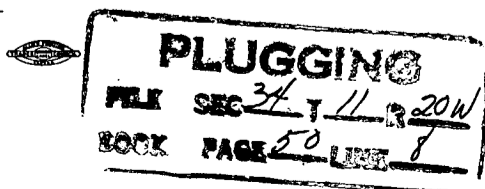

15-051-03578-00-00

TRANSIT CORPORATION -FRANK

HOMEURG #1
SE SE SW Section 34-11-20W
Ellis Co., Kan.

ELEVATION: 2157 D.M.
2154 Cr.
COMMENCED: July 7, 1954
COMPLETED: July 19, 1954

<u>FORMATION</u>	<u>FROM</u>	<u>TO</u>
Sand & Shells	0	40
Shale & Shells	40	187
Shale	187	1015
Sand	1015	1220
Shale & Shells	1220	1260
Shale, Shells, Red Bed	1260	1558
Anhydrite	1558	1625
Shale & Shells	1625	2250
Broken Lime	2250	2345
Shale & Lime	2345	2610
Lime, Broken	2610	2735
Lime & Shale	2735	2795
Lime	2795	2940
Shale & Lime Shells	2940	3035
Shale & Lime	3035	3225
Lime Broken	3225	3290
Lime & Shale	3290	3379
Lime	3379	3435
Lime & Shale	3435	3463
Lime	3463	3792
Marmaton Chert & Lime	3792	3805
Lime & Shale	3805	3831
Conglomerate	3831	3867
Cherty Congl.	3867	3905
Chert	3905	3911
Cherty Congl.	3911	3938
Arbuckle	3938	3965
Total Depth		3965

DRY HOLE

I hereby certify the foregoing to be a true and accurate Driller's Log of the formations encountered in the above well.

TRANSIT CORPORATION

By: C. W. Dodson

C. W. Dodson

Subscribed and sworn to before me this 21st day of July, 1954.

My commission expires February 11, 1957.

Emmett Cubber
Notary Public

