


WELL PLUGGING RECORD

Give All Information Completely
Make Required Affidavit
Mail or Deliver Report to:
Conservation Division
State Corporation Commission
800 Bittling Building
Wichita, Kansas

Trego County. Sec. 7 Twp. 11S Rge. 21 (E)W (W)

Location as "NE/CNW $\frac{1}{4}$ SW $\frac{1}{4}$ " or footage from lines NE NE NW
Lease Owner Aurora Gasoline Company
Lease Name Osborne-Monroe Well No. 1
Office Address 308 Wright Building, Tulsa, Oklahoma
Character of Well (completed as Oil, Gas or Dry Hole) Dry Hole
Date well completed Dec. 20 1951
Application for plugging filed Dec. 20 1951
Application for plugging approved Dec. 20 1951
Plugging commenced Dec. 20 1951
Plugging completed Dec. 20 1951
Reason for abandonment of well or producing formation Dry Hole

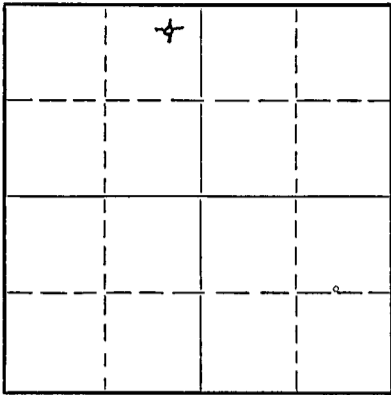

Locate well correctly on above Section Plat

If a producing well is abandoned, date of last production 19...
Was permission obtained from the Conservation Division or its agents before plugging was commenced? Yes

Name of Conservation Agent who supervised plugging of this well Eldon Petty
Producing formation Depth to top Bottom Total Depth of Well 3818 Feet
Show depth and thickness of all water, oil and gas formations.

OIL, GAS OR WATER RECORDS

CASING RECORD

Formation	Content	From	To	Size	Put In	Pulled Out
		0	152'	8 5/8"	152'	None

Describe in detail the manner in which the well was plugged, indicating where the mud fluid was placed and the method or methods used in introducing it into the hole. If cement or other plugs were used, state the character of same and depth placed, from...feet to...feet for each plug set.

3818' - 151 $\frac{1}{2}$ ' - Heavy Rotary Mud
151 $\frac{1}{2}$ ' - 150' - Wooden Plug
150' - 104' - 15 sacks cement
104' - 41 $\frac{1}{2}$ ' - Heavy Rotary Mud
41 $\frac{1}{2}$ ' - 40' - Wooden Plug
40' - 6' - 10 sacks cement
6' - Surface - Cellar

(If additional description is necessary, use BACK of this sheet)

Name of Plugging Contractor Glenn W. Peel
Address P. O. Box 359, Hoisington, Kansas

STATE OF Kansas, COUNTY OF Barton, ss.
Glenn W. Peel (employee of owner) or (~~owner or operator~~) of the above-described well,
being first duly sworn on oath, says: That I have knowledge of the facts, statements, and matters herein contained and the log of the above-described well as filed and that the same are true and correct. So help me God.

BY: GLENN W. PEEL
(Signature) P. O. Box 359
HOISINGTON, KANSAS
(Address)

SUBSCRIBED AND SWORN to before me this 28th day of December, 1951

My commission expires June 4, 1955 Notary Public.

23-8390-s 6-51-20M

DEC 31 1951
12-31-1951

7811 21W
133 5

15-195-00508-00-00

DRILLER'S LOG

Company: Peel-Hardman Oil Producers
Aurora Gasoline Company

NE NE NW
Sec. 7, Twp. 11S, Rge. 21W,

Farm: Osborne-Monroe Well No. 1

County: Trego, Kansas

Total Depth: 3818'

Comm: 12-6-51 Comp: 12-20-51

Elevation:

Contractor: Glenn W. Peel

Casing:

8 5/8" 152' cem.

Production: Dry

Figures below indicate bottom of formations

Surface Soil	0 -	150
Shale		700
Sand & Shale		1020
Shale		1360
Shale & Shells		1560
Anhydrite		1600
Shale & Shells		1730
Shale		1920
Shale & Shellsq		2210
Lime		3818
Total Depth		3818

This is to certify that the above information is, to the best of our knowledge true and correct.

GLENN W. PEEL

BY: Glenn W. Peel

SUBSCRIBED AND SWORN to before me this 28th day of December, 1951.

My commission expires June 4, 1955 Marion M. Herbert
Notary Public

PLUGGING
FILE SEC 7 T11 R 21W
BOOK PAGE 133 LINE 5

12-31-1951