


Give All Information Completely
Make Required Affidavit
Mail or Deliver Report to:
Conservation Division
State Corporation Commission
211 No. Broadway
Wichita, Kansas

WELL PLUGGING RECORD

NORTH

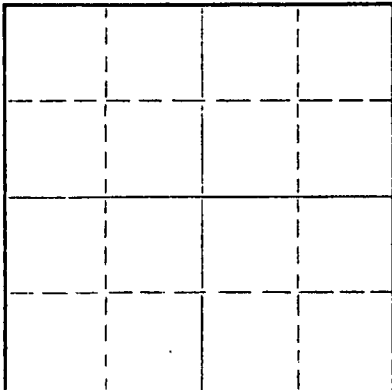

Locate well correctly on above
Section Plat

Trego County. Sec. 9 Twp. 11 Rge. 21 (E) (W)
Location as "NE/CNW/SW" or footage from lines SW SW NW
Lease Owner Martin & Keller
Lease Name ~~XXXXXXXXXXXXXXXXXXXX~~ Akers Well No. 1
Office Address 713 Kennedy Bldg, Tulsa, Okla.
Character of Well (completed as Oil, Gas or Dry Hole) Dry Hole
Date well completed 8-30-64 19
Application for plugging filed 8-30-64 19
Application for plugging approved 8-30-64 19
Plugging commenced 8-30-64 19
Plugging completed 8-30-64 19
Reason for abandonment of well or producing formation Dry Hole

If a producing well is abandoned, date of last production 19
Was permission obtained from the Conservation Division or its agents before plugging was commenced? yes

Name of Conservation Agent who supervised plugging of this well W. L. Nichols, Moreland, Kansas
Producing formation _____ Depth to top _____ Bottom _____ Total Depth of Well 3772 Feet
Show depth and thickness of all water, oil and gas formations.

OIL, GAS OR WATER RECORDS

CASING RECORD

FORMATION	CONTENT	FROM	TO	SIZE	PUT IN	PULLED OUT
				8 5/8"	216'	none

Describe in detail the manner in which the well was plugged, indicating where the mud fluid was placed and the method or methods used in introducing it into the hole. If cement or other plugs were used, state the character of same and depth placed, from _____ feet to _____ feet for each plug set.

Plug @ 600; with 20 sks. cement
Plug @ 200' with 20 sks. cement
Plug & 1/2 sk. hulls @ 40' with 10 sks. cement

RECEIVED
STATE CORPORATION COMMISSION
9-1-1964
SEP 1 1964

CONSERVATION DIVISION
Wichita, Kansas

(If additional description is necessary, use BACK of this sheet)

Name of Plugging Contractor Leben Drilling, Inc.
Address P. O. Box 486, Great Bend, Kansas

STATE OF KANSAS, COUNTY OF BARTON, ss.
Leslie Kite

(employee of owner) or (owner or operator) of the above-described well, being first duly sworn on oath, says: That I have knowledge of the facts, statements, and matters herein contained and the log of the above-described well as filed and that the same are true and correct. So help me God.

(Signature) Leslie Kite
P. O. Box 486, Great Bend, Kansas
(Address)

SUBSCRIBED AND SWORN TO before me this 31st day of August, 19 64.

My commission expires April 1, 1967

Ulanda Nichols
Ulanda Nichols Notary Public.

15-195-00457-00-00

DRILLER'S LOG

COMPANY: Martin & Keller
 CONTRACTOR: LEBEN DRILLING, INC.
 FARM: AKERS #1
 LOCATION: SW SW NW Sec. 9-11-21
 TREGO COUNTY, KANSAS
 COMMENCED: 8-22-64
 COMPLETED: 8-30-64

0	30	Surface Soil
30	75	Post Rock
75	155	Shale & Shells
155	1565	Shale
1565	1613	Anhydrite
1613	2150	Shale & Shells
2150	2380	Lime
2380	2720	Lime & Shale
2720	2930	Shale & Lime
2930	3080	Shale
3080	3175	Shale & Shells
3175	3441	Lime & Shale
3441	3666	Lime
3666	3695	Conglomerate
3695	3700	Arbuckle
3700	3762	Chert
3762	3772	Arbuckle
	<u>3772</u>	<u>Rotary Total Depth - D. & A.</u>

STATE GEOLOGICAL COMMISSION
 9-1-1964
 SEP 1 1964
 CONSERVATION DIVISION
 Wichita, Kansas

Set 8 5/8" used surface casing @ 216' with 175 sacks 60-40 Posmix with Sunset

I, Leslie Kite, do hereby certify that the above and foregoing is a true and correct copy of the log of the Akers #1 well, located SW SW NW of Section 9, Township 11, Range 21, Trego County, Kansas, as reflected by the files of Leben Drilling, Inc.

Leslie Kite
 Leslie Kite

STATE OF KANSAS)
) SS
 COUNTY OF BARTON)

Subscribed and sworn to before me, a Notary Public, in and for Barton County, Kansas, this 31st day of August, 1964.

Ulanda Nichols
 Ulanda Nichols

My Commission Expires
 April 1, 1967