


WELL PLUGGING RECORD

Give All Information Completely
Make Required Affidavit
Mail or Deliver Report to:
Conservation Division
State Corporation Commission
212 No. Market
Wichita, Kansas

NORTH

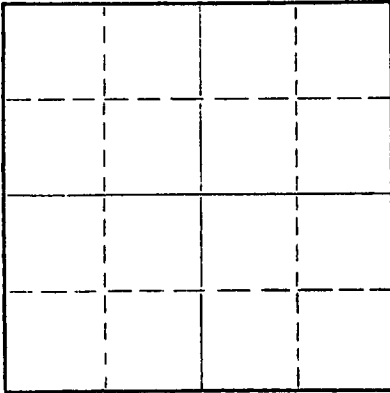

Locate well correctly on above
Section Plat

Trego County, Sec. 10 Twp. 11S Rge. 21W (E) (W)
Location as "NE/CNW/SW" or footage from lines NE/SE/NW
Lease Owner D & D Drilling Company, Inc.
Lease Name Taylor Well No. 1
Office Address 307 Schweiter Building, Wichita, Kansas
Character of Well (completed as Oil, Gas or Dry Hole) Dry Hole
Date well completed 4-2-66 19
Application for plugging filed 4-6-66 19
Application for plugging approved 4-6-66 19
Plugging commenced 4-2-66 19
Plugging completed 4-2-66 19
Reason for abandonment of well or producing formation Dry Hole

If a producing well is abandoned, date of last production 19
Was permission obtained from the Conservation Division or its agents before plugging was commenced? yes

Name of Conservation Agent who supervised plugging of this well Gilbert Leiker, Victoria, Kansas
Producing formation Depth to, top Bottom Total Depth of Well 3785 Feet
Show depth and thickness of all water, oil and gas formations.

OIL, GAS OR WATER RECORDS

CASING RECORD

FORMATION	CONTENT	FROM	TO	SIZE	PUT IN	PULLED OUT
Surface Hole		0	175'	8 5/8"	3-25-66	

Describe in detail the manner in which the well was plugged, indicating where the mud fluid was placed and the method or methods used in introducing it into the hole. If cement or other plugs were used, state the character of same and depth placed, from feet to feet for each plug set.

Set Plug #1 @ 540' with 20 sacks of cement

Set Plug #2 @ 165' with 20 sacks of cement

Set Plug #3 @ 40' with 10 sacks of cement

15-195-30117-00-00
APR 12 1966
4-12-1966

(If additional description is necessary, use BACK of this sheet)

Name of Plugging Contractor D & D Drilling Company, Inc.
Address 307 Schweiter Building, Wichita, Kansas

STATE OF Kansas, COUNTY OF Sedgwick, ss.
James R. Daniels (employee of owner) or (owner or operator) of the above-described well, being first duly sworn on oath, says: That I have knowledge of the facts, statements, and matters herein contained and the log of the above-described well as filed and that the same are true and correct. So help me God.

(Signature) James R. Daniels
James R. Daniels
307 Schweiter Bldg, Wichita, Kansas

SUBSCRIBED AND SWORN TO before me this 6th day of April, 19 66.

My commission expires 11-18-66

Colleen Chapple
Colleen Chapple Notary Public.

15-195-30117-00-00

ROTARY DRILLING LOG

OPERATOR: D & D Drilling Company, Inc.	COMMENCED: 3-25-66
CONTRACTOR: D & D Drilling Company, Inc.	COMPLETED: 4-2-66
WELL: Taylor No. 1	ELEVATION: 2118 R.B.
LOCATION: NE SE NW	2115 D.F.
Section 10-11S-21W	2113 G.L.
COUNTY: Trego, Kansas	TOTAL DEPTH: 3785'

Formations	Depth	Remarks
Shale & Sand	1563'	Set 4 joints of 8 5/8" casing @ 175' with 170 sacks of HA5
Anhydrite	1645'	
Shale & Sand	1900'	
Shale & Lime	3100'	
Lime & Shale	3400'	
Lime	3673'	
Lime & Shale	3742'	
Lime	3785'	
Rotary Total Depth	3785'	

RECEIVED
 STATE CORPORATION COMMISSION
 4-12-1966
 APR 12 1966
 CONSERVATION DIVISION
 WICHITA, KANSAS

A F F I D A V I T

State of Kansas)
) SS
 County of Sedgwick)

I, James R. Daniels, of lawful age, being duly and solemnly sworn on oath says: I am a resident of Wichita, Sedgwick County, Kansas, and I hereby know and on oath state that the above drilling log is true and correct to the best of my knowledge and belief.

James R. Daniels
 James R. Daniels

Subscribed and sworn to before me this 6th day of April, 1966.

My Commission Expires: 11-18-66

Colleen Chapple
 Colleen Chapple - Notary Public

