

Give All Information Completely
Make Required Affidavit
Mail or Deliver Report to:
Conservation Division
State Corporation Commission
212 No. Market
Wichita, Kansas

WELL PLUGGING RECORD

Trego County, Sec. 10 Twp. 11S Rge. (E) 21(W)

Location as "NE/CNW/SW" or footage from lines NW SW NW

Lease Owner R. M. Edwards

Lease Name Taylor Well No. 1

Office Address % S. A. Martin P.O. Box 635 Great Bend, Kansas

Character of Well (completed as Oil, Gas or Dry Hole) dry

Date well completed 7-26 19 68

Application for plugging filed 7-26 19 68

Application for plugging approved 7-26 19 68

Plugging commenced 3:30 7-26 19 68

Plugging completed 6:00 7-26 19 68

Reason for abandonment of well or producing formation dry

If a producing well is abandoned, date of last production 19

Was permission obtained from the Conservation Division or its agents before plugging was commenced? yes

Name of Conservation Agent who supervised plugging of this well Gilbert Leiker - Victoria, Kansas

Producing formation Depth to top Bottom Total Depth of Well 3780 Feet

Show depth and thickness of all water, oil and gas formations.

OIL, GAS OR WATER RECORDS CASING RECORD

FORMATION	CONTENT	FROM	TO	SIZE	PUT IN	PULLED OUT
		0	212	8 5/8	212	0

Describe in detail the manner in which the well was plugged, indicating where the mud fluid was placed and the method or methods used in introducing it into the hole. If cement or other plugs were used, state the character of same and depth placed, from feet to feet for each plug set.

Plugged hole with 100 sacks at 800' 25 sacks at 215' Plug and hulls
10 sacks at 30 feet 2 sacks in rat hole - plugged by Halliburton &
state plugger.

RECEIVED
STATE CORPORATION COMMISSION
JUL 30 1968
CONSERVATION DIVISION
Wichita, Kansas

Name of Plugging Contractor B & B Drilling, Inc. (If additional description is necessary, use BACK of this sheet)
Address 207 Petroleum Building, Wichita, Kansas

STATE OF Kansas COUNTY OF Sedgwick, ss.
Bill Lahar (employee of owner) or (owner or operator) of the above-described


well, being first duly sworn on oath, says: That I have knowledge of the facts, statements, and matters herein contained and the log of the above-described well as filed and that the same are true and correct. So help me God.

(Signature) Bill Lahar
207 Petroleum Building - Wichita, Kansas

SUBSCRIBED AND SWORN TO before me this 29th day of May, 1968

May 31, 1970 Alma A. Neeser Notary Public.

My commission expires

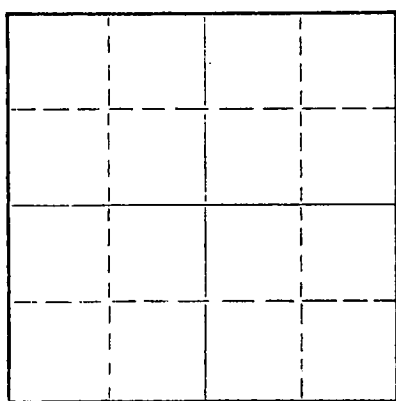

Locate well correctly on above Section Plat

15-195-20079-00-00

B & B DRILLING, INC.

548 Petroleum Building
Wichita, Kansas 67202

July 29, 1968

DRILLERS LOG

Re: Taylor #1
NW SW NW Sec. 10-11S-21W
Trego County, Kansas

COMPANY: R. M. Edwards
CONTRACTOR: B & B Drilling, Inc.
TOTAL DEPTH: 3780'
COMMENCED: July 17, 1968
COMPLETED: July 26, 1968

0	28	Soil & Sand
28	155	Clay & Shale
155	212	Clay & Shale
212	370	Shale
370	1265	Shale & Sand
1265	1557	Shale & Shells
1557	1600	Anhydrite
1600	2375	Lime & Shale
2375	2835	Lime
2835	2985	Lime
2985	3185	Lime
3185	3310	Lime
3310	3429	Lime
3429	3585	Lime
3585	3727	Lime
3727	3734	Lime
3734	3780	Arbuckle
3780		Total Depth D & A

RECEIVED
STATE CORPORATION COMMISSION
7-30-1968
JUL 30 1968
CONSERVATION DIVISION
Wichita, Kansas

We certify the above and foregoing to be true and correct copy of the log on the #1 Taylor, located in Trego County, Kansas.

Bill Laker President

Alma A. Meiser Notary Public

Subscribed and sworn to before me this
29th day of July, 1968
My commission expires May 31, 1970