


WELL PLUGGING RECORD

Give All Information Completely
Make Required Affidavit
Mail or Deliver Report to:
Conservation Division
State Corporation Commission
211 No. Broadway
Wichita, Kansas

NORTH

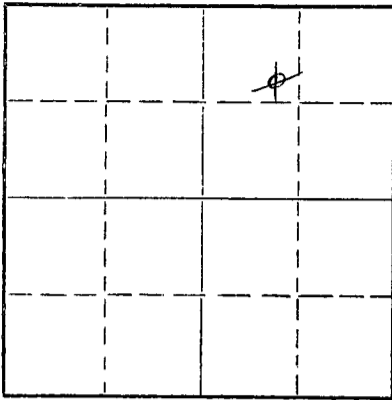

Locate well correctly on above
Section Plat

Trego County, Sec. 10 Twp. 11 Rge. 21 (E) (W)^x
Location as "NE/CNW/SW" or footage from lines SE NW NE
Lease Owner I. O. Miller
Lease Name Walz Well No. 1
Office Address 619 Brown Bldg-Wichita 2, Kansas
Character of Well (completed as Oil, Gas or Dry Hole) dry hole
Date well completed 7/22/57
Application for plugging filed " 19
Application for plugging approved " 19
Plugging commenced " 19
Plugging completed " 19
Reason for abandonment of well or producing formation

If a producing well is abandoned, date of last production 19
Was permission obtained from the Conservation Division or its agents before plugging was commenced? yes

Name of Conservation Agent who supervised plugging of this well Eldon Petty
Producing formation Depth to top Bottom Total Depth of Well 3760 Feet
Show depth and thickness of all water, oil and gas formations.

OIL, GAS OR WATER RECORDS

CASING RECORD

FORMATION	CONTENT	FROM	TO	SIZE	PUT IN	PULLED OUT
		0	250	8 5/8"	251	none

Describe in detail the manner in which the well was plugged, indicating where the mud fluid was placed and the method or methods used in introducing it into the hole. If cement or other plugs were used, state the character of same and depth placed, from feet to feet for each plug set.

Mudded to 600 ft - set plug w/ 25 sx cement
Mudded to 240 ft - set plug w/ 15 sx cement
Mudded to 40 ft - set plug w/ 10 sx cement

Name of Plugging Contractor Virginia Drig Co Inc. (If additional description is necessary, use BACK of this sheet)
Address 712 Brown Bldg-Wichita 2, Kansas

STATE OF Kansas COUNTY OF Sedgwick
S. A. Murphy ss.

(employee of owner) or (owner or operator) of the above-described well, being first duly sworn on oath, says: That I have knowledge of the facts, statements, and matters herein contained and the log of the above-described well as filed and that the same are true and correct. So help me God.

(Signature) S. A. Murphy
712 Brown Bldg-Wichita 2, Kansas (Address)

SUBSCRIBED AND SWORN TO before me this 25th day of April, 1958

My commission expires Febr. 5, 1961 Notary Public.

PLUGGING
FILE SEC 10 TWP 11 R 21W
BOOK PAGE 3 / LINE 9

4-26-1958
APR 26

15-195-00280-00-00

WALE # 1 - SE NW NE/4 Section 10-11-21 Erego County, Kansas
Company - I. O. Miller et al
Virginia Drilling Co., Inc.-Contractor
Commenced- June 27, 1957
Completed - July 22, 1957
Elevation - 2106 KB
Total Depth - 3760 ft. 8 5/8" set at 251 ft.

FORMATION ----- **DEPTH** -----

Shale-sand	0- 251	
Shale	251- 510	
Shale-shells	510-1050	TOPS:
Sand-shale	1050-1260	
Shale-redbed	1260-1556	3360 - Keebler
Anhydrite	1556-1600	3381 - Toronto
Shale-lime	1600-1825	3398 - Lansing
Lime-shale	1825-2160	3641- Base KB
Lime-shale	2160-2215	3687 - Marston chert
Lime	2215-2335	3722 - Conglomerate
Shale-lime	2335-2540	
Shale	2540-2620	
Shale-lime	2620-3315	
Lime	3315-3701	
Shale-lime	3701-3735	
Lime-chert	3735-3760 TD	

S. A. Murphy

S. A. Murphy

Subscribed and sworn to before me, a Notary Public,
this 29th day of July, 1957.

Marlee Hawkins

Notary Public - Marlee Hawkins

My commission expires: Febr. 5, 1961

PLUGGING
WELL NO. 10, 11, 21W
BOOK PAGE 31 LINE 9

RECEIVED
4-26-1958
APR 26 1958