


STATE OF KANSAS
STATE CORPORATION COMMISSION

WELL PLUGGING RECORD

Give All Information Completely
Make Required Affidavit
Mail or Deliver Report to:
Conservation Division
State Corporation Commission
211 No. Broadway
Wichita, Kansas

Russell County. Sec. 27 Twp. 11 Rge. 15 ~~(#)~~ W (W)
Location as "NE/CNW/SW" or footage from lines SW SW SE
Lease Owner PETROLEUM, INC.
Lease Name EULERT Well No. 1
Office Address Route #2, Great Bend, Kansas
Character of Well (completed as Oil, Gas or Dry Hole) Dry hole
Date well completed July 1 19 57
Application for plugging filed July 1 19 57
Application for plugging approved July 1 19 57
Plugging commenced July 1 19 57
Plugging completed July 1 19 57
Reason for abandonment of well or producing formation No producible zones

NORTH

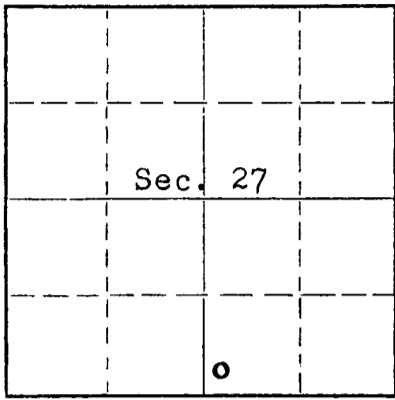

Locate well correctly on above
Section Plat

If a producing well is abandoned, date of last production none 19
Was permission obtained from the Conservation Division or its agents before plugging was commenced? yes

Name of Conservation Agent who supervised plugging of this well Milton Galyardt Russell, Kansas
Producing formation --- Depth to top -- Bottom -- Total Depth of Well 3249 Feet
Show depth and thickness of all water, oil and gas formations.

OIL, GAS OR WATER RECORDS

CASING RECORD

FORMATION	CONTENT	FROM	TO	SIZE	PUT IN	PULLED OUT
				8-5/8"	197'	none

Describe in detail the manner in which the well was plugged, indicating where the mud fluid was placed and the method or methods used in introducing it into the hole. If cement or other plugs were used, state the character of same and depth placed, from feet to feet for each plug set.

Mud up to 400' with heavy mud, pushed down 1/3 sack hulls to 400' followed by wooden plug. Placed 100 sacks cement through drill pipe onto plug. Mud up to 35' and place 1/3 sack hulls at 35' followed by wooden plug and 10 sacks cement to base of well cellar.

7-8-1957

(If additional description is necessary, use BACK of this sheet)

Name of Plugging Contractor Garvey Drilling Company
Address Route #2, Great Bend, Kansas

STATE OF KANSAS, COUNTY OF BARTON, ss.
DON SEARLE (employee of owner) or (~~owner or operator~~) of the above-described

well, being first duly sworn on oath, says: That I have knowledge of the facts, statements, and matters herein contained and the log of the above-described well as filed and that the same are true and correct. So help me God.

(Signature) Don Searle
Route #2, Great Bend, Kansas
(Address)

SUBSCRIBED AND SWORN to before me this 5th day of July, 19 57

My commission expires July 11, 1960

Ted L. Brown
Notary Public.

PLUGGING
FILE SEC 27 T 11 R 15W
BOOK PAGE 25 LINE 6

WELL LOG

15-167-00267-00-00

COMPANY PETROLEUM, INCORPORATED

SEC. 27 T. 11S R. 15W

FARM EULERT

NO. 1

LOC. Approx. SW,SW,SE


TOTAL DEPTH 3249'

COUNTY Russell Co., Kansas

COMM. June 20, 1957

COMP. July 1, 1957

CONTRACTOR GARVEY DRILLING COMPANY

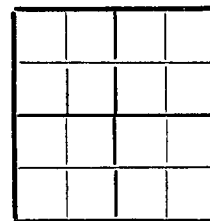

CASING 8 5/8" @ 197' W/150 sax.

ELEVATION 1733' DF

PRODUCTION D & A

FIGURES INDICATE BOTTOM OF FORMATIONS

45	Surface clay & rock
75	Shale
250	Shale & shells
780	Red bed & shale
810	Red bed W/sand streaks
850	Anhydrite
1240	Shale & shells
1350	Shale
2608	Lime & shale
3249	Lime
3249	T. D.

PLUGGING
 FILE SEC. 27 T. 11 R. 15W
 BOOK PAGE 15 LINE 6

7-8-1957

State of KANSAS }
 County of BARTON } ss:

I, Verne A. Morris of Garvey Drilling Co.

upon oath state that the above and foregoing is a true and correct copy of the log of the #1 Eulert well

Verne A. Morris

Subscribed and sworn to before me this 3rd day of July 19 57

My Commission Expires: November 12, 1958

Beaufort
 NOTARY PUBLIC