


15-051-00989-00-00

STATE OF KANSAS
STATE CORPORATION COMMISSION

WELL PLUGGING RECORD

Give All Information Completely
Make Required Affidavit
Mail or Deliver Report to:
Conservation Division
State Corporation Commission
800 Bitting Building
Wichita, Kansas

NORTH

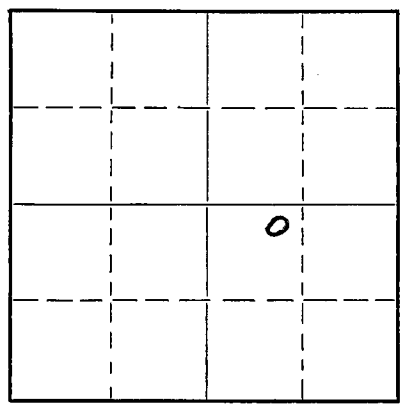

Locate well correctly on above
Section Plat

Ellis County. Sec. 15 Twp. 11S Rge. 16 (E) (W)
Location as "NE/CNW 1/4 SW 1/4" or footage from lines 1650' NAL, 330' SCL - S3/4
Lease Owner Gulf Oil Corporation
Lease Name Anna Baum Well No. 1
Office Address Box 661, Tulsa, Oklahoma
Character of Well (completed as Oil, Gas or Dry Hole) Dry hole
Date well completed February 9, 19 50
Application for plugging filed February 9, 19 50
Application for plugging approved February 9, 19 50
Plugging commenced February 10, 19 50
Plugging completed February 10, 19 50
Reason for abandonment of well or producing formation Well was completed as a dry hole.
If a producing well is abandoned, date of last production None 19
Was permission obtained from the Conservation Division or its agents before plugging was commenced? Yes

Name of Conservation Agent who supervised plugging of this well P. Coplin
Producing formation Arbuckle Depth to top 3514 Bottom 3521 Total Depth of Well 3521 Feet
Show depth and thickness of all water, oil and gas formations.

OIL, GAS OR WATER RECORDS

CASING RECORD

| Formation | Content | From | To | Size | Put In | Pulled Out |
|-----------|---------|------|----|--------|--------|------------|
| | | | | 8-5/8" | 1033' | None |
| | | | | | | |
| | | | | | | |
| | | | | | | |
| | | | | | | |
| | | | | | | |
| | | | | | | |
| | | | | | | |
| | | | | | | |

Describe in detail the manner in which the well was plugged, indicating where the mud fluid was placed and the method or methods used in introducing it into the hole. If cement or other plugs were used, state the character of same and depth placed, from _____ feet to _____ feet for each plug set.

Mudded from TD to 250' and dumped 15 sacks cement. Mudded to 35' and set HOWCO cement plug and dumped 10 sacks cement to base of cellar.

2-28-1950

(If additional description is necessary, use BACK of this sheet)

Correspondence regarding this well should be addressed to S. G. Sanderson
Address Box 661, Tulsa, Oklahoma

STATE OF Kansas, COUNTY OF Rice, ss.
H. H. Wright (employee of owner) of the above-described well,
being first duly sworn on oath, says: That I have knowledge of the facts, statements, and matters herein contained and the log of the above-described well as filed and that the same are true and correct. So help me God.

(Signature) [Signature] (Address) Box 544 Chan Kansas

SUBSCRIBED AND SWORN TO before me this 20th day of February, 1950.

My commission expires April 14, 1952 [Signature] Notary Public.

PLUGGING
FILE SEC-15 T-11 R-16a
BOOK PAGE 138 LINE 21

