

15-051-04823-00-00


STATE OF KANSAS  
STATE CORPORATION COMMISSION

Form CP-4

Give All Information Completely  
Make Required Affidavit  
Mail or Deliver Report to:  
Conservation Division  
State Corporation Commission  
P. O. Box 17027

WELL PLUGGING RECORD

Wichita, Kansas 67217  
NORTH

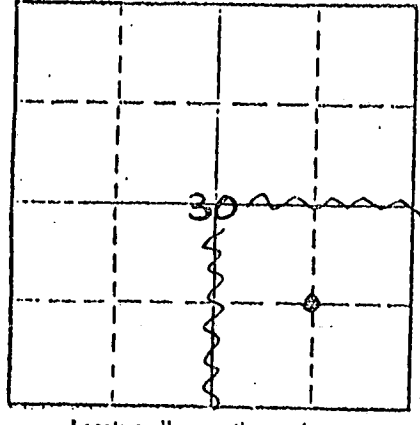

Locate well correctly on above Section Plat

Ellis County, Sec. 30 Twp. 11S Rge. 17W (W) W  
Location as "NE/CNW/SE/SW" or footage from lines. C SE/4  
Lease Owner Champlin Petroleum Company  
Lease Name Hadley "L" Well No. 2  
Office Address 6441 N.W. Grand Blvd., Suite 300, OKC, OK 73116  
Character of Well (completed as Oil, Gas or Dry Hole) Oil Well  
Date well completed 12/19 1982  
Application for plugging filed 5/24 1982  
Application for plugging approved 6/8 1982  
Plugging commenced 8/31 1982  
Plugging completed 9/1 1982  
Reason for abandonment of well or producing formation Uneconomical

If a producing well is abandoned, date of last production 9/16 1972  
Was permission obtained from the Conservation Division or its agents before plugging was commenced? yes

Name of Conservation Agent who supervised plugging of this well G. Scheck  
Producing formation Arbuckle Depth to top 3538 Bottom 3551 Total Depth of Well 3570 Feet  
Show depth and thickness of all water, oil and gas formations.

OIL, GAS OR WATER RECORDS

CASING RECORD

FORMATION	CONTENT	FROM	TO	SIZE	PUT IN	PULLED OUT
Arbuckle		3558	3551	8 5/8	1275	0
				4 1/2	3570	0

Describe in detail the manner in which the well was plugged, indicating where the mud fluid was placed and the method or methods used in introducing it into the hole. If cement or other plugs were used, state the character of same and depth placed, from \_\_\_\_\_ feet to \_\_\_\_\_ feet for each plug set.

Mix and Pump 70 sacks 60-40 Pozmix cement w/6% gel and 5 sacks cottonseed hulls. Connect to 8 5/8 x 4 1/2" annulus and mix and pump 180 sacks 60-40 Pozmix cement w/6% gel into annulus. Connect back to the casing and mix and pump 250 sacks 60-40 Pozmix cement w/6% gel. Maximum pressure 400#. Shut well in w/200# pressure on well. Shut-in over night. Cement settled 42 feet over night - Hand filled casing with cement and cap well w/1 sack cement. Well is P&A

RECEIVED  
STATE CORPORATION COMMISSION  
9-20-1982  
SEP 20 1982  
CONSERVATION DIVISION  
Wichita, Kansas

Name of Plugging Contractor Halliburton  
Address Hays, Kansas

STATE OF Oklahoma, COUNTY OF Oklahoma ss.

J. W. Meyers (employee of owner) or (owner or operator) of the above-described well, being first duly sworn on oath, says: That I have knowledge of the facts, statements, and matters herein contained and the log of the above-described well as filed and that the same are true and correct. So help me God.

(Signature) [Signature]  
6441 N.W. Grand Blvd. Suite 300, OKC, OK 73116  
(Address)

Subscribed and Sworn to before me this 15th day of September, 1982

[Signature]  
Notary Public

My commission expires 10/8/83



