

15-051-03647-00-00

WELL PLUGGING RECORD

Give All Information Completely
Make Required Affidavit
Mail or Deliver Report to:
Conservation Division
State Corporation Commission
800 Biting Building
Wichita, Kansas

Ellis

County. Sec. 30 Twp. 11 Rge. (E) 17 (W)

Location as "NE/CNW%SW%" or footage from lines Center N/2 N/2 NW/4

Lease Owner Isern Drilling Company

Lease Name Peavey Well No. 1

Office Address Box 45, Ellinwood, Kansas

Character of Well (completed as Oil, Gas or Dry Hole) Dry Hole

Date well completed October 13, 1953 19

Application for plugging filed October 13, 1953 19

Application for plugging approved October 13, 1953 19


Plugging commenced October 13, 1953 19

Plugging completed October 13, 1953 19

Reason for abandonment of well or producing formation Dry Hole

If a producing well is abandoned, date of last production _____ 19

Was permission obtained from the Conservation Division or its agents before plugging was commenced? Yes

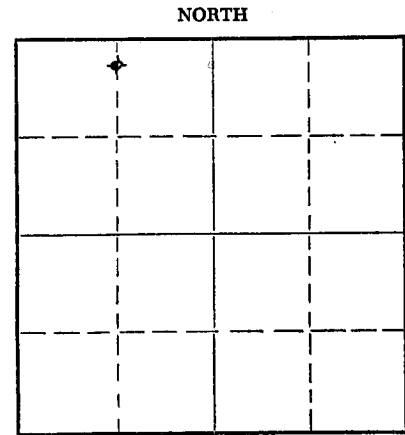

Locate well correctly on above Section Plat

Name of Conservation Agent who supervised plugging of this well Eldon Petty

Producing formation _____ Depth to top _____ Bottom _____ Total Depth of Well 3693 Feet

Show depth and thickness of all water, oil and gas formations.

OIL, GAS OR WATER RECORDS

CASING RECORD

FORMATION	CONTENT	FROM	TO	SIZE	PUT IN	PULLED OUT
	Surface Pipe	0	225'	8-5/8"	225'	None

Describe in detail the manner in which the well was plugged, indicating where the mud fluid was placed and the method or methods used in introducing it into the hole. If cement or other plugs were used, state the character of same and depth placed, from _____ feet to _____ feet for each plug set.

Filled hole with heavy mud to 210'. Bridged hole at 210'. Run 15 sacks Lone Star cement 210' up. Bridge hole at 40'. Run 10 sacks cement, plug 40' to base of cellar.

Name of Plugging Contractor Isern Drilling Company
Address Box 45, Ellinwood, Kansas

(If additional description is necessary, use BACK of this sheet)

10-17-1953
OCT 17 1953

CONSERVATION DIVISION
Wichita, Kansas

STATE OF KANSAS, COUNTY OF BARTON, ss.

I, M. M. Shropshire

(employee of owner) or (owner or operator) of the above-described

well, being first duly sworn on oath, says: That I have knowledge of the facts, statements, and matters herein contained and the log of the above-described well as filed and that the same are true and correct. So help me God.

(Signature) M. M. Shropshire
Lyons, Kansas

(Address)

SUBSCRIBED AND SWORN TO before me this 16th day of October, 1953

George A. Meyer
Notary Public.

My commission expires Feb. 10, 1955.

24-7368-5 3-53-20M

PLUGGING
OCT 30 11 17 53
136

15-051-03647-00-00

WELL LOG

ISERN DRILLING COMPANY ETAL, Owner - Peavey #1
Center N/2 N/2 NW/4 Section 30, Township 11, Range 17W,
Ellis County, Kansas

Elevation: 2091 DF

Figures indicate bottom of formation

Pipe Record:

8-5/8" set at 225'

Rotary commenced 10- 1-53
Completed 10-14-53

0	to	105	post rock
		635	shale & shells
		715	sand
		750	pyrit@ & sand
		1030	sand
		1308	Red rock
		1375	lime & shale
		1700	shale & shells
		1855	salt
		2000	shale & shells
		2990	lime & shale
		3035	shale & shells
		3225	lime & shale
		3610	lime
		3620	Conglomerate & chert
		3648	Conglomerate
		3653	shale
		3693	Arbuckle
		3693	Total Depth D&A

STATE OF KANSAS)
COUNTY OF BARTON) SS

I, M. M. Shropshire, Drilling Superintendent of the above-described well, being first duly sworn on oath, declare: That I have knowledge of the facts, statements and matters herein contained pertaining to the above-described well, as filed, and that the same are true and correct.

M. M. Shropshire

Subscribed and Sworn to before me this 16th day of October, 1953.

George A. Meyer

My commission expires Feb. 10, 1955.

RECEIVED
OCT 17 1953
CONSERVATION DIVISION
WICHITA, KANSAS

PLUGGING
FILE SEC 30 T 11 R 170
BOOK PAGE 36 LINE 11