


STATE OF KANSAS
STATE CORPORATION COMMISSION

Give All Information Completely
Make Required Affidavit
Mail or Deliver Report to:
Conservation Division
State Corporation Commission
211 No. Broadway
Wichita, Kansas

15-051-05169-00-00

WELL PLUGGING RECORD

NORTH

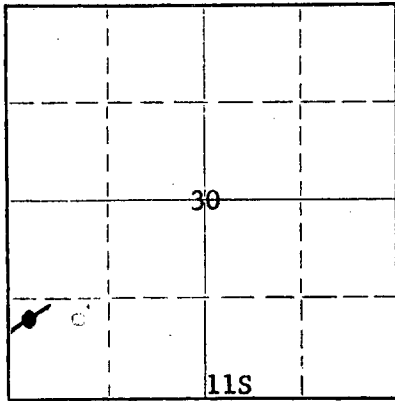

Locate well correctly on above
Section Plat

Ellis County, Sec. 30 Twp. 11S Rge. (E) 17 (W)

Location as "NE/CNW/SW" or footage from lines NW/4 SW/4 SW/4
Lease Owner Walters Drilling Co., et al
Lease Name Peavey Well No. 3
Office Address 510 Orpheum Building, Wichita 2, Kansas
Character of Well (completed as Oil, Gas or Dry Hole) abandoned oilwell
Date well completed June 16, 19 54
Application for plugging filed (verbal) August 13, 19 59
Application for plugging approved (verbal) August 13, 19 59
Plugging commenced August 13, 19 59
Plugging completed August 18, 19 59
Reason for abandonment of well or producing formation Dakota water broke in

If a producing well is abandoned, date of last production June 9, 19 59
Was permission obtained from the Conservation Division or its agents before plugging was commenced? Yes

Name of Conservation Agent who supervised plugging of this well Eldon Petty, Hays, Kansas
Producing formation Arbuckle Depth to top 3626' Bottom 3660' Total Depth of Well 3660 Feet
Show depth and thickness of all water, oil and gas formations.

OIL, GAS OR WATER RECORDS

CASING RECORD

FORMATION	CONTENT	FROM	TO	SIZE	PUT IN	PULLED OUT
None	None	0	176	8 5/8"	176	None
Arbuckle	oil	0	3659'	5 1/2"	3659'	448.45'

Describe in detail the manner in which the well was plugged, indicating where the mud fluid was placed and the method or methods used in introducing it into the hole. If cement or other plugs were used, state the character of same and depth placed, from _____ feet to _____ feet for each plug set.

Plugged back with sand from 3626' to 3300'. Mixed and dumped 4 sx. cement from 3300' to 3268'. Pulled 5 1/2" to 444'. Circulated 20 sacks gel mud. Pumped in 20 sacks cement from 444' to 384', pulled pipe to 175'. Pumped in 20 sacks cement from 175' to 115'. Pulled rest of pipe. Bailed off mud to 40'. Set 10' rock bridge from 40' to 30'. Mixed and dumped 10 sacks cement from 30' to base of cellar.

RECEIVED
STATE CORPORATION COMMISSION
8-24-1959
AUG 24 1959
CONSERVATION DIVISION
Wichita, Kansas

(If additional description is necessary, use BACK of this sheet)

Name of Plugging Contractor Ace Pipe Pulling Co.
Address Box 304, Great Bend, Kansas - License No. 2

STATE OF Kansas, COUNTY OF Sedgwick, ss.
Robert F. Walters (owner or operator) of the above-described well, being first duly sworn on oath, says: That I have knowledge of the facts, statements, and matters herein contained and the log of the above-described well as filed and that the same are true and correct. So help me God.

(Signature) Robert F. Walters
510 Orpheum Building, Wichita 2, Kansas
(Address)

SUBSCRIBED AND SWORN TO before me this 20th day of August, 19 59
Pauline Henderson
Notary Public.

My commission expires March 10, 1960

PLUGGING
FILE SEC 30 T. 11 R. 17
BOOK PAGE 62 LINE 30

15-051-05169-00-00


WELL LOG BUREAU - KANSAS GEOLOGICAL SOCIETY
508 East Murdock, Wichita, Kansas

Company- WALTERS DRILLING CO.
Farm- Peavey No. 3

SEC. 30 T. 11 R. 17W
NW. SW. SW

Total Depth. 3660'
Comm. 6-1-54 Comp. 6-16-54
Shot or Treated.
Contractor. Walters Drilling Co.
Issued. 8-7-54

Country Ellis KANSAS

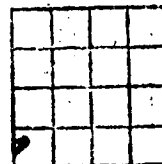

CASING:
8 5/8" 176' cem w/100 sx
5 1/2" 3659' cem w/75 sx

Elevation. 2099' DF

Production. Pmp. 25 & no wtr.

Figures indicate Bottom of Formations.

surface	176
shale & shells	680
shale, shells & sand	857
sand	1010
shale & shells	1344
anhydrite	1383
shale & shells	2010
shale & lime	2210
lime	2280
lime & shale	2390
lime	2410
lime & shale	2565
shale	2658
lime & shale	3081
lime	3249
lime & shale	3347
lime	3383
lime & shale	3660 RTD
Total Depth	

Tops:	
Anhydrite	1344
Heebner	3294
Simpson	3602
Arbuckle	3626