

15-051-03649-00-00

STATE OF KANSAS
STATE CORPORATION COMMISSION

Give All Information Completely
Make Required Affidavit
Mail or Deliver Report to:
Conservation Division
State Corporation Commission
800 Bitting Building
Wichita, Kansas

WELL PLUGGING RECORD

Ellis County, Sec. 30 Twp. 11S Rge. 17 (X) (W)

Location as "NE/CNW/SW" or footage from lines NW/4 NE/4 SW/4

Lease Owner Walters Drilling Co., et al

Lease Name Peavey Well No. 5

Office Address 510 Orpheum Building, Wichita 2, Kansas

Character of Well (completed as Oil, Gas or Dry Hole) Dry Hole

Date well completed September 20, 19 54

Application for plugging filed (verbal) September 20, 19 54

Application for plugging approved (verbal) September 20, 19 54

Plugging commenced September 20, 19 54

Plugging completed September 21, 19 54

Reason for abandonment of well or producing formation Dry Hole

If a producing well is abandoned, date of last production 19

Was permission obtained from the Conservation Division or its agents before plugging was commenced? Yes

Name of Conservation Agent who supervised plugging of this well Eldon Petty, Hays, Kansas

Producing formation Depth to top Bottom Total Depth of Well 3710 Feet

Show depth and thickness of all water, oil and gas formations.

OIL, GAS OR WATER RECORDS

CASING RECORD

| FORMATION | CONTENT | FROM | TO | SIZE | PUT IN | PULLED OUT |
|-----------|---------|---------------------------------------|------|--------|--------|------------|
| None | None | 0 | 194' | 8 5/8" | 194' | None |
| | | No oil string run - dry and abandoned | | | | |
| | | | | | | |
| | | | | | | |
| | | | | | | |
| | | | | | | |
| | | | | | | |
| | | | | | | |

Describe in detail the manner in which the well was plugged, indicating where the mud fluid was placed and the method or methods used in introducing it into the hole. If cement or other plugs were used, state the character of same and depth placed, from feet to feet for each plug set.

Set bottom plug at 180' with heavy mud and 15 sacks cement

Set top plug at 40' with 10 sacks cement and heavy mud

Name of Plugging Contractor Walters Drilling Co.
Address 510 Orpheum Building, Wichita 2, Kansas

STATE OF KANSAS COUNTY OF SEDGWICK

Russell I. Baker (employee of owner)

I, being first duly sworn on oath, says: That I have knowledge of the facts, statements, and matters herein contained and the log of the above-described well as filed and that the same are true and correct. So help me God.

(Signature) Russell I. Baker
510 Orpheum Building, Wichita 2, Kansas

(Address)

SUBSCRIBED AND SWORN TO before me this 23rd day of September, 19 54


Pauline Rudolph
Notary Public.

My commission expires March 10, 1956

24-2675-8 2-52-20M

PLUGGING
FILE SEC 30 T 11 R 17W
BOOK PAGE 166 LINE 31

RECEIVED
STATE CORPORATION COMMISSION
9-28-1954
SEP 28 1954
CONSERVATION DIVISION
Wichita, Kansas

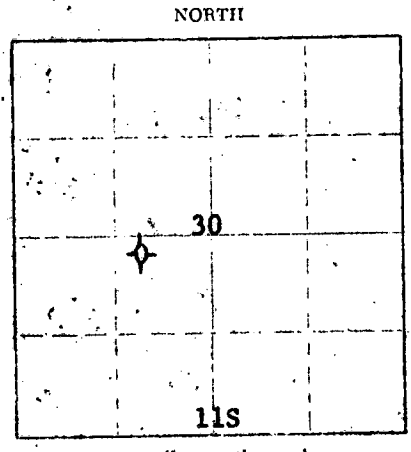

Locate well correctly on above Section Plat

15-051-03649-00-00

PEAVEY NO. 5

| | | | |
|-----------------|--|--------------------|-------------------------------|
| Location: | NW NE SW Sec. 30-11S-17W Ellis County, Kansas | Date Spudded: | 9-9-54 |
| Operator: | Walters Drilling Co. | Rotary Completion: | 9-20-54 |
| Contractor: | Walters Drilling Co. | Elevation: | 2109 Gr 2111 DF 2113 KB |
| Surface Casing: | 8 5/8" set at 194' with 100 sacks cement and 1 Cal. Chloride | | |
| Oil String: | None. D & A | | |

L O G

(Figures indicate bottom of formation)

| | |
|------------------|----------|
| Surface | 0 to 194 |
| Shale and Shells | 860 |
| Sand | 1015 |
| Shale and Shells | 1360 |
| Anhydrite | 1400 |
| Shale and Shells | 2055 |
| Shale and Lime | 2275 |
| Lime | 2570 |
| Lime and Shale | 3417 |
| Lime | 3588 |
| Lime and Shale | 3645 |
| Conglomerate | 3670 |
| Lime | 3676 |
| Lime and Shale | 3710 |
| Total Depth | 3710 |

The undersigned, Russell I. Baker, hereby certifies that the above log is a true and correct log of the formations encountered in drilling the above noted well as reflected by the Daily Drilling Reports.



WALTERS DRILLING CO.

By Russell I. Baker

Subscribed and sworn to before me
this 23rd day of September, 1954

Pauline Henderson

Notary Public

My commission expires:
March 10, 1956

RECEIVED
STATE CORPORATION COMMISSION
9-28-1954
SEP 28 1954
CONSERVATION DIVISION
Wichita, Kansas

PLUGGING
WELLS SEC 30 T 11 R 17W
BOOK PAGE 66 LINE 31