

WELL PLUGGING RECORD

Give All Information Completely
Make Required Affidavit
Mail or Deliver Report to:
Conservation Division
State Corporation Commission
800 Bitting Building
Wichita, Kansas

Ellis County, Sec. 30 Twp. 11S Rge. 17 (W)

Location as "NE/CNW%SW%" or footage from lines SW/4 NW/4 NW/4

Lease Owner Walters Drilling Co., Inc.

Lease Name Peavey "B" Well No. 1

Office Address 510 Orpheum Building, Wichita, Kansas

Character of Well (completed as Oil, Gas or Dry Hole) Dry Hole

Date well completed January 7, 19 54

Application for plugging filed (verbal) January 7, 19 54

Application for plugging approved (verbal) January 7, 19 54

Plugging commenced January 8, 19 54

Plugging completed January 8, 19 54

Reason for abandonment of well or producing formation Dry Hole

If a producing well is abandoned, date of last production 19

Was permission obtained from the Conservation Division or its agents before plugging was commenced? Yes

Name of Conservation Agent who supervised plugging of this well Eldon Petty, Hays, Kansas

Producing formation Depth to top Bottom Total Depth of Well 3550 Feet

Show depth and thickness of all water, oil and gas formations.

OIL, GAS OR WATER RECORDS

CASING RECORD

FORMATION	CONTENT	FROM	TO	SIZE	PUT IN	PULLED OUT
None	None	0	184'	8 5/8	184'	None
	cemented with 100 sacks cement and 1 sack Cal. Chloride					
	(No oil string run - dry and abandoned)					

Describe in detail the manner in which the well was plugged, indicating where the mud fluid was placed and the method or methods used in introducing it into the hole. If cement or other plugs were used, state the character of same and depth placed, from feet to feet for each plug set.

Set bottom plug at 175' with heavy mud and 10 sacks cement.

Set top plug at 40' with heavy mud and 10 sacks cement and 1 sack Hulls.

(If additional description is necessary, use BACK of this sheet)

Name of Plugging Contractor Walters Drilling Co., Inc.

Address 510 Orpheum Building, Wichita, Kansas

STATE OF KANSAS, COUNTY OF SEDGWICK, ss. Robert F. Walters (employee of owner) or (owner or operator) of the above-described well, being first duly sworn on oath, says: That I have knowledge of the facts, statements, and matters herein contained and the log of the above-described well as filed and that the same are true and correct. So help me God.

(Signature) Robert F. Walters

510 Orpheum Building, Wichita, Kansas

(Address)

SUBSCRIBED AND SWORN to before me this 14th day of January, 19 54

Pauline Richardson

Notary Public.


My commission expires March 10, 1956

24-7368-6 3-53-20M

PLUGGING
FILE SEC 30 T 11 R 17W
BOOK PAGE 7 LINE 27

1-15-1954

17 W

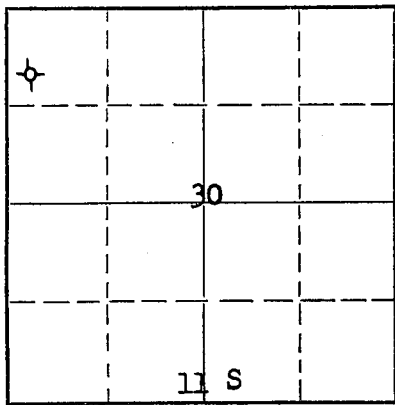

Locate well correctly on above Section Plat

15-051-03648-00-00

PEAVEY "B" NO. 1

Location: SW NW NW Sec. 30-11S-17W, Ellis County, Kansas Date Spudded: 12-28-53
Operator: Walters Drilling Co., Inc. Rotary Completion: 1-7-54
Contractor: Walters Drilling Co., Inc. Elevation: 1943 Gr
1945 DF
1947 KB
Surface Casing: 8 5/8" set at 184' with 100 sacks cement and 1 sack Cal. Chloride
Oil String: None. D & A

L O G

(Figures indicate bottom of formation)

Surface	0 to 184
Shale	448
Sand and Shale	690
Sand	850
Red Bed and Shale	1195
Anhydrite	1233
Shale and Shells	2082
Lime	2297
Lime and Shale	2675
Shale	2712
Shale and Shells	2905
Lime and Shale	2995
Lime	3550
Total Depth	3550

The undersigned, Robert F. Walters, hereby certifies that the above log is a true and correct log of the formations encountered in drilling the above noted well as reflected by the Daily Drilling Reports.


WALTERS DRILLING CO., INC.

By Robert F. Walters

Subscribed and sworn to before me
this 14th day of January, 1954.

Pauline Neuhoff
Notary Public

My commission expires: March 10, 1956

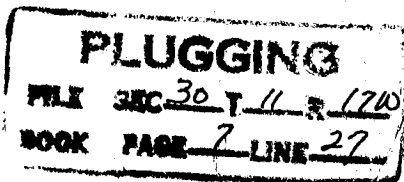

1-15-1954