

15-051-05070-00-00

STATE OF KANSAS
STATE CORPORATION COMMISSION

WELL PLUGGING RECORD

Give All Information Completely
Make Required Affidavit
Mail or Deliver Report to:
Conservation Division
State Corporation Commission
800 Bittling Building
Wichita, Kansas

Ellis County. Sec. 30 Twp. 11S Rge. 17 (E) W. (W)

Location as "NE/CNW $\frac{1}{4}$ SW $\frac{1}{4}$ " or footage from lines NW NW NW

Lease Owner Lario Oil & Gas Company

Lease Name Peavey "C" Well No. 1

Office Address 301 South Market, Wichita, Kansas

Character of Well (completed as Oil, Gas or Dry Hole) Oil

Date well completed May 31, 19 49

Application for plugging filed March 13, 19 53

Application for plugging approved March 16, 19 53

Plugging commenced March 31, 19 53

Plugging completed April 2, 19 53

Reason for abandonment of well or producing formation Depleted

If a producing well is abandoned, date of last production January 31, 19 53

Was permission obtained from the Conservation Division or its agents before plugging was commenced? Yes

Name of Conservation Agent who supervised plugging of this well Eldon Petty

Producing formation Arbuckle Depth to top 3463 Bottom 3514 $\frac{1}{2}$ Total Depth of Well 3514 $\frac{1}{2}$ Feet

Show depth and thickness of all water, oil and gas formations.

OIL, GAS OR WATER RECORDS

CASING RECORD

Formation	Content	From	To	Size	Put In	Pulled Out
				8 5/8	1217	Left in Cem. 550 sxs.
				5 1/2	3464	2742'

Describe in detail the manner in which the well was plugged, indicating where the mud fluid was placed and the method or methods used in introducing it into the hole. If cement or other plugs were used, state the character of same and depth placed, from _____ feet to _____ feet for each plug set.

Filled hole with sand from 3514 $\frac{1}{2}$ T.D. to 3450' and then dumped 4 sacks of cement. Mudded hole to 300'. Put in rock bridge and dumped in 20 sacks of cement. Mudded hole to 35'. Put in rock bridge and dumped 10 sacks of cement.

4-11-1953

(If additional description is necessary, use BACK of this sheet)

Name of Plugging Contractor West Supply Co.

Address Chase, Kansas

STATE OF Kansas, COUNTY OF Sedgwick, ss.

Leo Ross (employee of owner) or ~~owner or operator~~ of the above-described well,

being first duly sworn on oath, says: That I have knowledge of the facts, statements, and matters herein contained and the log of the above-described well as filed and that the same are true and correct. So help me God.

(Signature) *Leo Ross*

301 South Market, Wichita 2, Kansas (Address)


SUBSCRIBED AND SWORN to before me this 10th day of April, 19 53

Frances Leslie
Notary Public.

My commission expires July 21, 1954

23-8390-s 6-51-20M

PLUGGING
FILE SEC 30 T 11 R 17W
BOOK PAGE 84 LINE 25

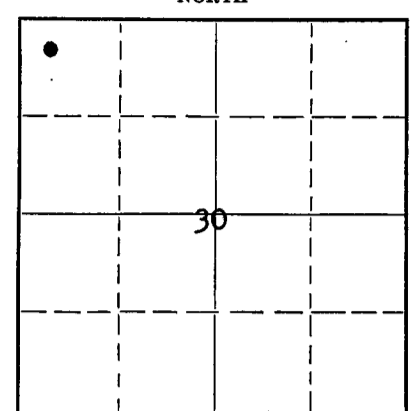

Locate well correctly on above Section Flat

15-051-05070-00-00

LARIO OIL & GAS COMPANY
Peavey "C" No. 1
NW NW NW Sec. 30-11S-17W
Ellis County, Kansas

Contractor - Sterling Drilling Company
Commenced - 5-4-49
Completed - 5-20-49 (rotary)

Total Depth - 3498 Derrick Floor

<u>Formation:</u>	<u>Depth:</u>	<u>Casing Record: (Derrick Floor)</u>
Shale	60	8 5/8" 1217 Cem. 550 sacks
Sand	88	5 1/2" 3464 Cem. 125 sacks
Shale & lime shells	125	
Shale & shells	500	<u>Geological Tops - Corr. Derrick Floor</u>
Sand & shale	560	Anhydrite 1205
Iron & sandy lime	635	Topeka 2908
Sand & shale	943	Heebner 3147
Shale & red bed	1195	Dodge 3156
Shale & red rock	1207	Lansing 3191
Anhydrite	1250	Simpson 3459
Shale & shells	1335	Arbuckle 3463
Red bed	1490	
Red bed and shale	1675	
Salt & shells	1710	3000 acid
Salt & shale	1735	Pot. 27 bbls. oil per day plus
Shells, shale & lime	1872	11% water.
Shale & lime	1945	
Sandy lime & shale	2065	
Shale & lime	2100	
Lime	2150	<u>DEEPENING RECORD:</u>
Shale & shells	2155	Deepening Commenced: 9-21-52
Shale & lime	2235	Deepening Completed: 9-24-52
Lime	2315	
Shale	2330	Dolomite 3504
Shale & lime	2410	Shale 3506 1/2
Lime	2440	Shale and dolomite 3509
Shale	2465	Shale 3511
Lime & shale	2795	Dolomite 3514 1/2
Shale	2845	
Shale & lime shells	2894	
Lime	2930	
Lime & shale	2992	
Lime	3165	
Lime & chert	3200	
Lime	3470	
Lime	3498	

PLUGGING
 FILE SEC 30 T 11 R 17W
 BOOK PAGE 84 LINE 25

RECEIVED
 SENT TO THE COMMISSION
 3-14-1953
 COMPLETION DIVISION
 Kansas