

WELL PLUGGING RECORD


FORMATION PLUGGING RECORD

STATE OF KANSAS STATE CORPORATION COMMISSION

Give All Information Completely Make Required Affidavit Mail or Deliver Report to: Conservation Division State Corporation Commission 800 Bitting Building Wichita, Kansas

Strike out upper line when reporting plugging off formations.

NORTH

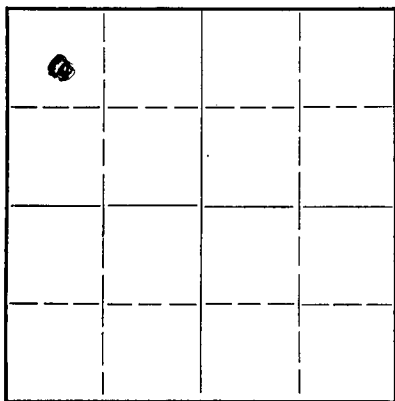

Locate well correctly on above Section Flat

Ellis County, Sec. 35 Twp. 11 Rge. (E) 17 (W)

Location as "NE 1/4 NW 1/4 SW 1/4" or footage from lines 330'S 330'E of N.W. Corner

Lease Owner Cities Service Oil Co.

Lease Name Hall "J" Well No. 2

Office Address Bartlesville, Oklahoma.

Character of Well (completed as Oil, Gas or Dry Hole) Dry Hole

Date well completed 4-8-43 19

Application for plugging filed 4-8-43 19

Application for plugging approved 4-8-43 19

Plugging commenced 4-8-43 19

Plugging completed 4-8-43 19

Reason for abandonment of well or producing formation Dry Hole

If a producing well is abandoned, date of last production 19

Was permission obtained from the Conservation Division or its agents before plugging was commenced? Yes

Name of Conservation Agent who supervised plugging of this well C.T. Alexander

Producing formation Arbuckle Lime Depth to top 3608' Bottom Total Depth of Well 3638' Feet

Show depth and thickness of all water, oil and gas formations.

OIL, GAS OR WATER RECORDS

CASING RECORD

Table with 7 columns: Formation, Content, From, To, Size, Put In, Pulled Out. Row 1: Arbuckle lime, Dry, 3608', 234', 8 5/8", 234', None.

Describe in detail the manner in which the well was plugged, indicating where the mud fluid was placed and the method or methods used in introducing it into the hold. If cement or other plugs were used, state the character of same and depth placed, from...feet to...feet for each plug set.

Filled with mud from T.D. 3638' to 234' set wood plug dumped 15 sacks cement, mud to 26' set plug and dumped 10 sacks cement mud and dirt to surface

PLUGGING RECORD 35 11 R 17W PAGE 69 LINE 45

5-3-1943

(If additional description is necessary, use BACK of this sheet)

Correspondence regarding this well should be addressed to Mr. R.C. Hauber Address Cities Service Oil Co. Great bend, Kansas.

STATE OF Kansas, COUNTY OF Barton, SS. Mr. J.A. Cleverley (employee of owner) or (owner or operator) of the above-described well,

being first duly sworn on oath, says: That I have knowledge of the facts, statements, and matters herein contained and the log of the above-described well as filed and that the same are true and correct. So help me God.

(Signature)

Cities Service Oil Co. Russell, Kansas.

(Address)

SUBSCRIBED AND SWORN to before me this 14th day of April 1943

My Commission Expires Mar. 12, 1947

Notary Public.



WELL RECORD

Company Cities Service Oil Co. Well No. 2 Farm Hall "J"  
 Location 330' South and 360' East of NW Corner Sec. 35 T. 11 R. 17-W  
 Elevation 1969 County Ellis State Kansas  
 Drig. Comm. March 21, 1943 Contractor Earl J. Wakefield  
 Drig. Comp. April 8, 1943 Acid None  
 T. D. 3638' Initial Prod. Dry - Plugged and Abandoned

CASING RECORD:

8-5/8" @ 234' con. 90 sx cement

FORMATION RECORD:

surface clay & sand	0-30
shale & shells	400
sand	420
shale & shells	721
sand	805
red rock & shale	1155
anhydrite	1191
shale, shells & red rock	1350
shale & shells	1520
salt & shale	1735
lime & shale	1765
lime broken	1928
shale with lime streaks	2012
lime broken	2495
lime	2520
shale & shells	2627
lime broken	2710
shale & shells	2768
shale & lime	2865
shale & shells	2920
lime	3168
shale	3202
lime	3307
shale	3373
lime	3429
shale	3444
lime	3452
conglomerate	3608
Arbuckle dolomite	3638 T. D.

Top Arbuckle 3608'  
 Penetration 30'  
 Total Depth 3638'

No show in Arbuckle.

Total Test: 1160' 0"  
 2500' 0"  
 3300' 0"

PLUGGING  
 FILE : 35 11 17W  
 BOOK PAGE - 69 45

WELL RECORD  
 STATE COMMISSION  
 GEOL. DIV.  
 MAY 3 - 1943  
 5-3-1943