

STATE OF KANSAS  
STATE CORPORATION COMMISSION

WELL PLUGGING RECORD


OR

Give All Information Completely  
Make Required Affidavit  
Mail or Deliver Report to:  
Conservation Division  
State Corporation Commission  
800 Bittling Building  
Wichita, Kansas

FORMATION PLUGGING RECORD

Strike out upper line  
when reporting plug-  
ging off formations.

NORTH

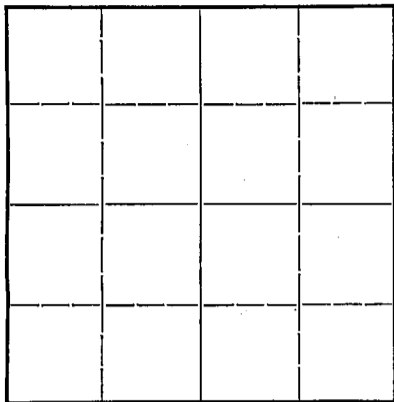

Locate well correctly on above  
Section Plat

Ellis County, Sec. 35 Twp. 11 Rge. (E) 17 (W)

Location as "NE 1/4 NW 1/4 SW 1/4" or footage from lines 330' N 330' E from S.W. Corner

Lease Owner Cities Service Oil Co.

Lease Name Hall "H" Well No. 1

Office Address Bartlesville, Oklahoma.

Character of Well (completed as Oil, Gas or Dry Hole) Dry

Date, well completed 6/22/41 19

Application for plugging filed 6/25/41 19

Application for plugging approved 6/25/41 19

Plugging Commenced 6/26/41 19

Plugging Completed 6/27/41 19

Reason for abandonment of well or producing formation Dry

If a producing well is abandoned, date of last production 19

Was permission obtained from the Conservation Division or its agents before plugging was commenced? Yes

Name of Conservation Agent who supervised plugging of this well #7 C.T. Alexander

Producing formation Arbuckle Lime Depth to top 3609' Bottom 3658' Total Depth of Well 3699' Feet

Show depth and thickness of all water, oil and gas formations.

OIL, GAS OR WATER RECORDS

CASING RECORD

Formation	Content	From	To	Size	Put In	Pulled Out
Arbuckle Lime	Dry			8 5/8"	215'	None
				4 1/2"	3608'	2636'

Describe in detail the manner in which the well was plugged, indicating where the mud fluid was placed and the method or methods used in introducing it into the hole. If cement or other plugs were used, state the character of same and depth placed, from feet to feet for each plug set.

Dumped 6 sacks cement in bottom, mud to 215' set wood plug, dumped 20' cement mud to 25', dumped 20' cement mud & dirt to surface.

(If additional description is necessary, use BACK of this sheet)

Correspondence regarding this well should be addressed to R.C. Hauber  
Address Cities Service Oil Co. Great Bend, Kansas

STATE OF Kansas, COUNTY OF Russell, ss.

J.A. Cleverley (employee of owner) or (owner or operator) of the above-described well, being first duly sworn on oath, says: That I have knowledge of the facts, statements, and matters herein contained and the log of the above-described well as filed and that the same are true and correct. So help me God.

(Signature)

Cities Service Oil Co. Russell, Kansas

1-24-1941

SUBSCRIBED AND SWORN to before me this 22 day of July 19 1941

My commission expires Jan. 26, 1942

WELL RECORD

Company **Cities Service Oil Co.** Well No. **1** Farm **Hall "H"**  
 Location **330' north & 330' east of SW Corner** Sec. **35** T. **11** S. R. **17-W**  
 Elevation **2108** County **Ellis** State **Kansas**  
 Drig. Comm. **May 6, 1941** Contractor **Twin Drilling Company**  
 Drig. Comp. **June 11, 1941** Acid **500 gals. (6-7-41); 1500 gals. (6-8-41).**  
 T. D. **3658** Initial Prod. **Dry - P. & A.**

CASINO RECORD:

6-5/8" @ 215' con. 75 ex Common and 25  
 ex Clickset  
 4-1/2" @ 3608' con. 100 ex Lone Star;  
 pulled 2636'.

FORMATION RECORD:

lime hard	0-40
lime & shale	215
shale blue soft	350
sandy shale & shells	590
sand white soft	600
sand red soft	720
shale red soft	780
sand grey soft	940
shale & shells med.	1065
sand red hard	1130
shale red	1215
shale red & shells	1305
anhydrite hard	1345
shale & shells red med.	1411
shale & shells	1720
salt, shale & shells	1875
shale & shells med.	1955
lime light hard	2040
lime grey hard	2074
lime broken med.	2102
lime & shale breaks	2180
lime grey med.	2223
lime grey hard	2450
shale blue & shells	2523
lime grey hard	2621
lime & shale breaks	2676
lime grey hard	2662
lime broken med.	2672
lime light hard	2700
lime & shale breaks	2740
lime broken	2800
shale & shells med.	2835
lime grey hard	2948
shale blue & shells	3058
shale & shells	3099
lime grey hard	3241

lime light hard	3585
lime hard	3501
lime light hard	3508
lime corod (sec. 3')	3611
3611 Rot. TD = 3608 SLM	
dolomite	3608-3629
lime	3658 T. D.

Fillup: 75' muddy oil in 1 1/2 hrs. @  
 3611. Bailed dry and hole  
 filled 60' oil in 19 1/2 hrs.  
 Total fillup 600' in 2 1/2 hrs.  
 @ 3629.

Acidized with 500 gals. June 7, 1941.  
 Reacidized with 1500 gals. in 54 hrs.  
 Stripped 1/2 bbl. oil per hour.  
 Deepened to 3658.  
 1700' fluid (half water) in hole.

Grfo:	500'	0°
	1000'	0°
	1500'	0°
	2000'	0°
	2500'	0°
	3000'	0°

Corr. Top Arbuckle	3606
Penetration	52
Total Depth	3658

PLUGGING  
 FILE NO. 35-11-1712  
 BOOK PAGE 42 LINE 316

7-24-1941  
 STATE OF KANSAS  
 COUNTY OF ELLIS