


STATE OF KANSAS
 STATE CORPORATION COMMISSION

Give All Information Completely
 Make Required Affidavit
 Mail or Deliver Report to:
 Conservation Division
 State Corporation Commission
 800 Bittling Building
 Wichita, Kansas

FORMATION PLUGGING RECORD

Strike out upper line
 when reporting plug-
 ging off formations.

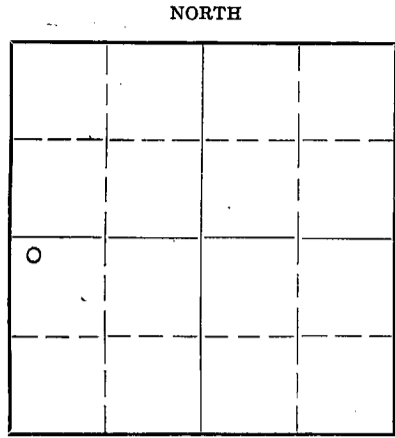

Locate well correctly on above
 Section Plat

Ellis County Sec. 35 Twp. 11S Rge. 17 (E) W (W)
 Location as "NE1/4NW1/4SW1/4" or footage from lines. NW NW SW
 Lease Owner Anderson-Prichard Oil Corporation
 Lease Name Hall "B" Well No. 1
 Office Address Oklahoma City, Oklahoma
 Character of Well (completed as Oil, Gas or Dry Hole) Dry hole
 Date well completed August 28 19 43
 Application for plugging filed August 28 19 43
 Application for plugging approved August 28 19 43
 Plugging commenced August 28 19 43
 Plugging completed August 28 19 43
 Reason for abandonment of well or producing formation Dry hole

If a producing well is abandoned, date of last production 19
 Was permission obtained from the Conservation Division or its agents before plugging was com-
 menced? Yes

Name of Conservation Agent who supervised plugging of this well C. T. Alexander
 Producing formation Depth to top Bottom Total Depth of Well 3650 Feet
 Show depth and thickness of all water, oil and gas formations.

OIL, GAS OR WATER RECORDS

CASING RECORD

Formation	Content	From	To	Size	Put In	Pulled Out
				13 3/8	87 ft.	None

Describe in detail the manner in which the well was plugged, indicating where the mud fluid was placed and the method or methods used in introducing it into the hold. If cement or other plugs were used, state the character of same and depth placed, from feet to feet for each plug set.

Filled with mud to 275 ft.
 Set Halliburton bridging plug
 at 275 ft. and placed 15 sack
 cement plug on top of bridge.
 Filled with heavy mud to 20 ft.
 and cement to 5 ft. and mud to
 surface.

FILE 35 11 17W
 BOOK 89 39

(If additional description is necessary, use BACK of this sheet)

Correspondence regarding this well should be addressed to Anderson-Prichard Oil Corporation
 Address Oklahoma City, Oklahoma

STATE OF _____, COUNTY OF _____, ss.
 _____ (employee of owner) or (owner or operator) of the above-described well,

being first duly sworn on oath, says: That I have knowledge of the facts, statements, and matters herein contained and the log of the above-described well as filed and that the same are true and correct. So help me God.

(Signature) *Western Payne*

(Address) *September 19 43*


SUBSCRIBED AND SWORN to before me this *3rd* day of *September* 19 *43*

R. P. Prichard
 Notary Public.

My commission expires *Oct. 2, 1945*

9-8-1943

15-051-03629-00-00

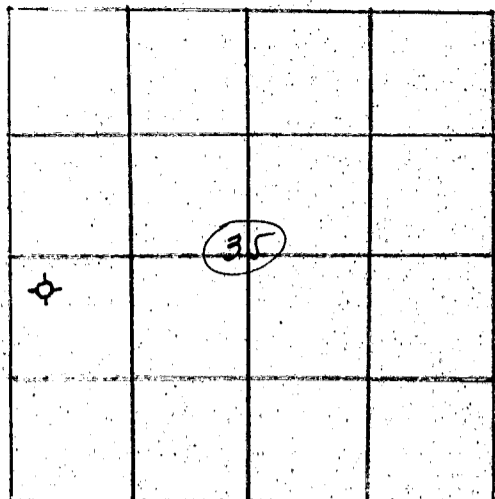

WELL RECORD:

ANDERSON-PRICHARD OIL CORPORATION, OKLA. CITY, OKLA.

HALL "B" #1 - NW NW SW Section 35-11S-17W,
Ellis County, Kansas

CONTRACTOR - MERCURY DRILLING COMPANY, TULSA, OKLA.

DRILLING COMMENCED - AUGUST 9, 1943

DRILLING COMPLETED - AUGUST 28, 1943

ROTARY - 0' to 3650'

Section 35, Township 11 South,
Range 17 West, Ellis County, Kansas

CASING RECORD:

Set and cemented 5 jts. of 12 $\frac{1}{2}$ " surface casing at 100' with 100 sacks Halliburton bulk cement.

FORMATION RECORD

<u>FORMATION</u>	<u>TOP</u>	<u>BOTTOM</u>
Sand, Rock	0	50
Shale	50	60
Shale & Shells	60	100
Shale	100	255
Shale & Shells	255	415
Sand & Shells	415	610
Sand & Shale	610	1005
Red Rock & Shale	1005	1230
Iron, Shale & Shells	1230	1296
Lime	1296	1331
Shale & Shells	1331	1665
Salt & Shale	1665	1680
Salt & Shells	1680	1875
Shale & Shells	1875	1920
Broken Lime	1920	2017
Lime & Shale	2017	2160
Lime	2160	2240
Lime & Shale	2240	2292
Lime (Hard)	2292	2365
Lime	2365	2425
Lime & Shale	2425	2465
Lime (Med)	2465	2558
Lime	2558	2645
Lime & Shale	2645	2835
Lime	2835	2860
Lime, Broken	2860	2940
Shale & Shells	2940	3035
Lime & Shale	3035	3095
Lime	3095	3167
Broken Lime	3167	3171
Lime	3171	3212
Lime & Shale	3212	3358
Lime	3358	3519
Lime & Shale	3519	3608
Lime	3608	3650

We hereby certify that the above is a true and correct record of the log on the Hall "B" #1 well in the Northwest quarter of the Northwest quarter of the Southwest quarter of Section 35, Township 11 South, Range 17 West, Ellis County, Kansas.

MERCURY DRILLING COMPANY

35 11 17W
89 39

Chester H. Westfall

BY
CHESTER H. WESTFALL, PRESIDENT