


15051-19017-00-00

WELL PLUGGING RECORD

Give All Information Completely
Make Required Affidavit
Mail or Deliver Report to:
Conservation Division
State Corporation Commission
212 North Market, Insurance Bldg.
Wichita, Kansas

Ellis County, Sec. 29 Twp. 11 Rge. 19 (E) W (W)

Location as "NE/CNW%SW%" or footage from lines SW SW SE
Lease Owner Woodman & Iannitti Drilling Company
Lease Name Solomon Well No. 1
Office Address 714 Union National Building, Wichita, Kansas
Character of Well (completed as Oil, Gas or Dry Hole) Dry Hole
Date well completed 4-28 1961
Application for plugging filed 4-28 1961
Application for plugging approved 4-28 1961
Plugging commenced 4-28 1961
Plugging completed 4-28 1961
Reason for abandonment of well or producing formation Dry

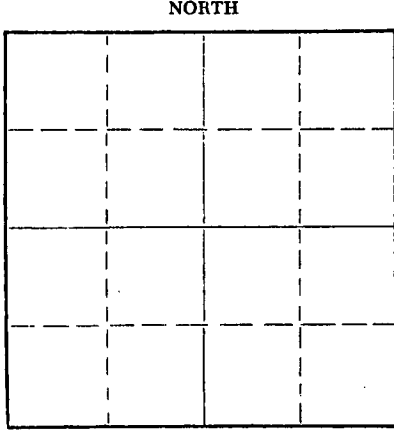

Locate well correctly on above Section Plat

If a producing well is abandoned, date of last production 19
Was permission obtained from the Conservation Division or its agents before plugging was commenced? Yes

Name of Conservation Agent who supervised plugging of this well Eldon Petty
Producing formation Depth to top Bottom Total Depth of Well 3761 Feet
Show depth and thickness of all water, oil and gas formations.

OIL, GAS OR WATER RECORDS

CASING RECORD

FORMATION	CONTENT	FROM	TO	SIZE	PUT IN	PULLED OUT
				8 5/8"	184'	

Describe in detail the manner in which the well was plugged, indicating where the mud fluid was placed and the method or methods used in introducing it into the hole. If cement or other plugs were used, state the character of same and depth placed, from feet to feet for each plug set.

Bottom plug at 600' with 20 sacks of cement
Middle plug at 180' with 20 sacks of cement
Top plug at 40' with 10 sacks of cement

RECEIVED
STATE CORPORATION COMMISSION
5-1-1961
MAY 1 1961
CONSERVATION DIVISION
Wichita, Kansas

(If additional description is necessary, use BACK of this sheet)
Name of Plugging Contractor Woodman & Iannitti Drilling Company
Address 714 Union National Building, Wichita, Kansas

STATE OF Kansas, COUNTY OF Sedgwick, ss.
K. T. Woodman (employee of owner) or (owner or operator) of the above-described well, being first duly sworn on oath, says: That I have knowledge of the facts, statements, and matters herein contained and the log of the above-described well as filed and that the same are true and correct. So help me God.

(Signature) K. T. Woodman
714 Union National Bldg., Wichita, Kansas
(Address)

SUBSCRIBED AND SWORN to before me this 28th day of April, 1961

My commission expires December 29, 1964

Agnes L. Kuhn
Notary Public.



15-051-19017-00-00

DRILLING LOG

Company: Woodman & Iannitti Drilling Company
Lease: #1 SOLOMON SW SW SE 29-11-19W
Ellis County, Kansas
Contractor: Woodman & Iannitti Drilling Company
714 Union National Building
Wichita, Kansas
Date Commenced: 4-19-61
Date Completed: 4-28-61
Total Depth: 3761'
Casing: 8 5/8" at 184' with 140 sacks quick set cement

Figures Indicate the Bottom of Formation

0-40	Post Rock	2020	Shale & Shells
140	Post Rock-Streak of Sand	2695	Lime
183	Blue Shale	2970	Lime & Shale
600	Shale	3045	Lime
685	Sand	3185	Broken Lime Shale
810	Shale & Sand	3620	Lime
950	Shale	3665	Lime Chert
1160	Sand	3755	Lime
1326	Red Bed	3761	Arbuckle Dolomite
1444	Red Bed & Shale		
1485	Anhydrite		

GEOLOGICAL TOPS

Elevation	2100	RB
Anhydrite	1444	+656
Heebner	3345	-1245
Toronto	3365	-1265
Lensing	3385	-1285
Marmston Chert	3654	-1554
Conglomerate	3670	-1570
Arbuckle	3753	-1653
Total Depth	3761	-1661

RECEIVED
STATE CONSERVATION COMMISSION
5-1-1961
MAY 2 1961
CONSERVATION DIVISION
Wichita, Kansas

I certify the above to be a true and correct copy of the Driller's Log and the geological tops to the best of my knowledge and belief.

WOODMAN & IANNITTI DRILLING COMPANY

By: K. T. Woodman
K. T. Woodman