

STATE OF KANSAS
STATE CORPORATION COMMISSION


Form CP-4

WELL PLUGGING RECORD

Give All Information Completely
Make Required Affidavit
Mail or Deliver Report to:
Conservation Division
State Corporation Commission
212 No. Market
Wichita, Kansas

Sheridan County, Sec. 7 Twp. 9S Rge. (E) 26 (W)

Location as "NE/CNW/SW" or footage from lines SW NE NW
Lease Owner Beacon Resources Corp.
Lease Name Hoffner Haffner et al Well No. 1
Office Address 1000 Century Plaza - Wichita, Kansas
Character of Well (completed as Oil, Gas or Dry Hole) dry
Date well completed 12-11 1969
Application for plugging filed 12-11 1969
Application for plugging approved 12-11 1969
Plugging commenced 12:00 12-11 1969
Plugging completed 1:45 12-11 1969
Reason for abandonment of well or producing formation dry

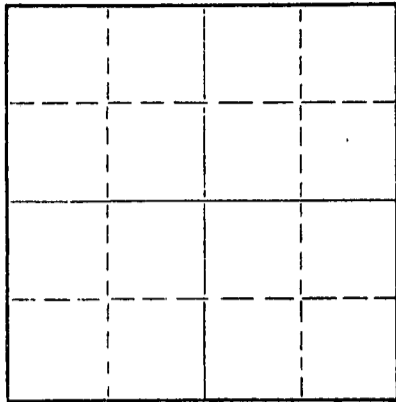

Locate well correctly on above
Section Plat

If a producing well is abandoned, date of last production 19
Was permission obtained from the Conservation Division or its agents before plugging was commenced? yes

Name of Conservation Agent who supervised plugging of this well Bill Nichols - Morland, Kansas
Producing formation none Depth to top Bottom Total Depth of Well 3990 Feet
Show depth and thickness of all water, oil and gas formations.


OIL, GAS OR WATER RECORDS

CASING RECORD

FORMATION	CONTENT	FROM	TO	SIZE	PUT IN	PULLED OUT
Sand & Shale		0	287	8 5/8	287	0

Describe in detail the manner in which the well was plugged, indicating where the mud fluid was placed and the method or methods used in introducing it into the hole. If cement or other plugs were used, state the character of same and depth placed, from feet to feet for each plug set.

Plugged hole - plug @ 1325' w/100 sx - plug @ 310' w/25 sx
Plug & Bridge to hold key @ 40' w/ 10 sx - 2 sx in rat hole

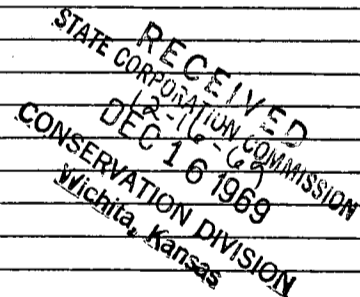

(If additional description is necessary, use BACK of this sheet)
Name of Plugging Contractor B & B Drilling, Inc.
Address 207 Petroleum Building Wichita, Kansas

STATE OF Kansas, COUNTY OF Sedgwick, ss.
Bill Lahar (employee of owner) or (owner or operator) of the above-described well, being first duly sworn on oath, says: That I have knowledge of the facts, statements, and matters herein contained and the log of the above-described well as filed and that the same are true and correct. So help me God

(Signature) Bill Lahar
207 Petroleum Building - Wichita, Kansas
(Address)

SUBSCRIBED AND SWORN to before me this 15th day of December, 19 69
Alma A. Neises
Notary Public.



B & B DRILLING, INC.

548 Petroleum Building
Wichita, Kansas 67202

December 15, 1969

RECEIVED
STATE CORPORATION COMMISSION
DEC 16 1969
CONSERVATION DIVISION
Wichita, Kansas

DRILLERS LOG

Re: Hoffner #1
SW NE NW Sec. 7-9S-26W
Sheridan County, Kansas

COMPANY:	Beacon Resources Corp.
CONTRACTOR:	B & B Drilling, Inc.
COMMENCED:	December 3, 1969
COMPLETED:	December 11, 1969
TOTAL DEPTH:	3990'

Set 8 5/8" @ 287' w/175 sx

0	288	Sand & Shale
288	485	Shale
485	1345	Shael & Sand
1345	1845	Shale
1845	1990	Sand
1990	2208	Shale & Red Bed
2208	2238	Anhydrite
2238	2245	Anhydrite
2245	2560	Shale
2560	2764	Shale
2764	2880	Shale & Lime
2880	3180	Shale & Lime
3180	3515	Shale & Lime
3515	3795	Lime & Shale
3795	3834	Lime
3834	3848	Lime
3848	3892	Lime
3892	3906	Lime
3906	3933	Lime
3933	3990	Lime
3990		Total Depth

DST #1
DST #2
DST #3
D & A

We certify the above and foregoing to be true and correct copy of the log on the #1 Hoffner, located in Sheridan County, Kansas.

Bruce Sahay President

Alma A. Neiser Notary Public
Subscribed and sworn to befor me this 15th day
of December, 1969. My commission expires
May 31, 1970

