

STATE OF KANSAS
 STATE CORPORATION COMMISSION
 130 S. Market, Room 2078
 Wichita, KS 67202

15-051-25140-00-00
 WELL PLUGGING RECORD
 K.A.R.-82-3-117

API NUMBER 15-051-25140-0000

LEASE NAME Keller

WELL NUMBER 1

330 Ft. from S Section Line

2,970 Ft. from E Section Line

SEC. 18 TWP. 11 SRGE. 19 REX or (W)

COUNTY Ellis

Date Well Completed 6-23-02

Plugging Commenced 6-23-02

Plugging Completed 6-23-02

RECEIVED
 7-2-2002
 JUL 02 2002
 KCC WICHITA

TYPE OR PRINT
 NOTICE: Fill out completely
 and return to Cons. Div.
 office within 30 days.

LEASE OPERATOR Pintail Petroleum, LTD

ADDRESS 225 N. Market, #300, Wichita, KS 67202

PHONE (316) 263-2243 OPERATORS LICENSE NO. 5086

Character of Well D & A

(Oil, Gas, D&A, SWD, Input, Water Supply Well)

The plugging proposal was approved on 6-22-02 (date)

by Roger Moses (KCC District Agent's Name).

Is ACO-1 filed? No If not, is well log attached? Yes

Producing Formation _____ Depth to Top _____ Bottom _____ T.O. 3,583'

Show depth and thickness of all water, oil and gas formations.

OIL, GAS OR WATER RECORDS

CASING RECORD

Formation	Content	From	To	Size	Put In	Pulled out
				8 5/8"	260'	Cmtd. w/175 sax

Describe in detail the manner in which the well was plugged, indicating where the mud fluid was placed and the method or methods used in introducing it into the hole. If cement or other plugs were used, state the character of same and depth placed, from feet to feet each set. Push plug to 1,360', spot 25 sax cement on plug thru drill pipe; push plug to 660', spot 100 sax cement on plug thru drill pipe; push plug to 310', spot 40 sax cement on plug thru drill pipe; push wiper plug to 40', dump 10 sax cement on plug to cellar; dump 15 sax cement down rat hole and 10 sax down mouse hole.

Name of Plugging Contractor Shields Drilling Co. License No. 5184

Address Box 709, Russell, KS 67665

NAME OF PARTY RESPONSIBLE FOR PLUGGING FEES: PINTAIL PETROLEUM, LTD


STATE OF KANSAS COUNTY OF RUSSELL, ss.

Jack P. Beeman, Sec.-Treas. (Employee of ~~XXXXXX~~ or ~~XXXXXX~~) Contractor above-described well, being first duly sworn on oath, says: That I have knowledge of the fact statements, and matters herein contained and the log of the above-described well as filed in the same are true and correct, so help me God.

(Signature) Jack P. Beeman

(Address) Box 709, Russell, KS 67665

SUBSCRIBED AND SWORN TO before me this 1st day of July, 2002

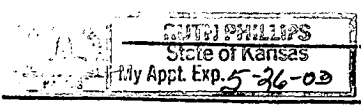My Commission Expires: 

Ruth Phillips
 Notary Public



15-051-25140-00-00


Shields

Russell, Kansas

WELL LOG

Operator: Pintail Petroleum, LTD
 Well: Keller #1
 Commenced: June 17, 2002
 Completed: June 23, 2002
 Contractor: Shields Drilling Co.

Well Description: SE SE SW
 Sec. 18-11S-19W
 Ellis Co., KS

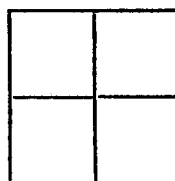

Elevation: 1,986' KB

Treatment:

Production: D & A

Tops:

CASING RECORD

Size	Run	Pulled
8 5/8"	260'	Cmtd. w/175 sax

RECEIVED
 7-2-2002
 JUL 02 2002
 KCC WICHITA

..... Figures Indicate Bottom of Formations

Sand & shale	1,348'	
Anhydrite	1,387'	
Shale	2,900'	
Shale & lime	3,085'	
Lime	3,340'	
Lime & shale	3,355'	
Lime	3,518'	
Shale & lime	3,583'	RTD

Notes