


15-195-00281-00-00

WELL PLUGGING RECORD

Give All Information Completely  
Make Required Affidavit  
Mail or Deliver Report to:  
Conservation Division  
State Corporation Commission  
211 No. Broadway  
Wichita, Kansas

Trego County. Sec. 30 Twp. 11S Rge. (E) 22 (W)

Location as "NE/CNW/SW" or footage from lines NE NE NE  
Lease Owner Earl F. Wakefield and Cooperative Refinery Assoc  
Lease Name Hixson Well No. 1  
Office Address 515 Union Center Building  
Character of Well (completed as Oil, Gas or Dry Hole) Dry Hole  
Date well completed March 15 19 57  
Application for plugging filed March 15 19 57  
Application for plugging approved March 15 19 57  
Plugging commenced March 15 19 57  
Plugging completed March 15 19 57  
Reason for abandonment of well or producing formation \_\_\_\_\_

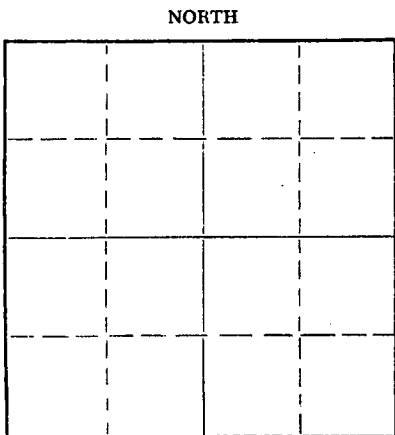

Locate well correctly on above  
Section Plat

If a producing well is abandoned, date of last production \_\_\_\_\_ 19 \_\_\_\_\_  
Was permission obtained from the Conservation Division or its agents before plugging was commenced? Yes

Name of Conservation Agent who supervised plugging of this well Eldon Petty  
Producing formation \_\_\_\_\_ Depth to top \_\_\_\_\_ Bottom \_\_\_\_\_ Total Depth of Well 4088 Feet  
Show depth and thickness of all water, oil and gas formations.

OIL, GAS OR WATER RECORDS

CASING RECORD

FORMATION	CONTENT	FROM	TO	SIZE	PUT IN	PULLED OUT
				8 5/8"	216'	None

Describe in detail the manner in which the well was plugged, indicating where the mud fluid was placed and the method or methods used in introducing it into the hole. If cement or other plugs were used, state the character of same and depth placed, from \_\_\_\_\_ feet to \_\_\_\_\_ feet for each plug set.

Hole filled W/heavy mud to 210 ft.  
Plug cemented W/20 sacks cement @ 210 ft.  
Top plug set @ 40 ft. cemented W/10 sacks cement

(If additional description is necessary, use BACK of this sheet)

Name of Plugging Contractor Earl F. Wakefield  
Address 515 Union Center Building, Wichita, Kansas

STATE OF KANSAS, COUNTY OF SEDGWICK, ss.  
Earl F. Wakefield ~~owner or operator~~ (owner or operator) of the above-described well, being first duly sworn on oath, says: That I have knowledge of the facts, statements, and matters herein contained and the log of the above-described well as filed and that the same are true and correct. So help me God.

(Signature) Earl F. Wakefield  
515 Union Center Building  
(Address)

SUBSCRIBED AND SWORN TO before me this 20<sup>th</sup> day of March, 1957

My commission expires July 26, 1958

C. A. Snow Notary Public.

PLUGGING  
FILE SEC. 30 T. 11 R. 22W  
BOOK PAGE 149 LINE 29

IVED  
3-23-1957  
CONSERVATION DIVISION  
Wichita, Kansas

15-195-00281-00-00

LEASE: Hixson #1  
OWNERS: Earl F. Wakefield &  
Cooperative Refinery Assoc.  
CONTRACTOR: Earl F. Wakefield  
COMM: 2-28-57 COMP: 3-14-57

LOCATION: NE NE NE 30-11S-22W  
Trego County, Kansas  
CASING: 8 5/8" Set @ 216'

Elevation: 2310' G.L.  
2320' K.B.

TOPS

Shale	890	Toronto Lime	3565
Shale & Sand	1475	K. C. Lime	3580
Shale and Red Bed	1775	Ft. Scott Lime	3903
Anhydrite	1825	Cong.	3980
Shale & Lime Stks	2385	Arbuckle	4055
Lime & Shale	2900		
Sandy Shale & Lime	3095		
Shale & Sandy Shale	3165		
Shale & Lime	3200		
Lime	3225		
Sandy Shale & Lime	3430		
Lime W/Stk of Chalky Lime	3535		
Lime	3675		
Lime & Shale	3744		
Lime	3810		
Lime & Shale	3905		
Lime, Cherty	3934		
Lime	3980		
Lime & Chert	4020		
Lime	4035		
Chert	4032		
Lime	4088		
T.R.D.	4088		

STATE OF KANSAS )  
                          ) SS  
COUNTY OF SEDGWICK )

I hereby agree and certify that the above is a true and correct copy of the log on the Hixson #1 well located NE NE NE 30-11S-22W, Trego County, Kansas.

Earl F. Wakefield  
Earl F. Wakefield

Sworn and subscribed before me this 20<sup>th</sup> day of March, 1957.

C. A. Snow  
C. A. Snow

My Commission Expires: July 26, 1958



PLUGGING  
FILE SEC. 30 T. 11 R. 22W  
BOOK PAGE 149 LINE 29

RECEIVED  
STATE CORPORATION COMMISSION  
3-23-1957  
MAR 23 1957  
CONSERVATION DIVISION  
Wichita, Kansas