


15-195-00101-00-00

WELL PLUGGING RECORD

Give All Information Completely
Make Required Affidavit
Mail or Deliver Report to:
Conservation Division
State Corporation Commission
212 North Market, Insurance Bldg.
Wichita, Kansas

Trego County, Sec. 2 Twp. 11S Rge. 23W (E) (W)

Location as "NE/CNW/SW" or footage from lines C SE NW
Lease Owner Burch Drilling Co., Inc.
Lease Name McCall Well No. 1
Office Address 1011 Union Center, Wichita, Kansas
Character of Well (completed as Oil, Gas or Dry Hole) Dry Hole
Date well completed 10-15-59 19
Application for plugging filed 10-15-59 19
Application for plugging approved 10-15-59 19
Plugging commenced 10-15-59 19
Plugging completed 10-15-59 19
Reason for abandonment of well or producing formation Dry Hole

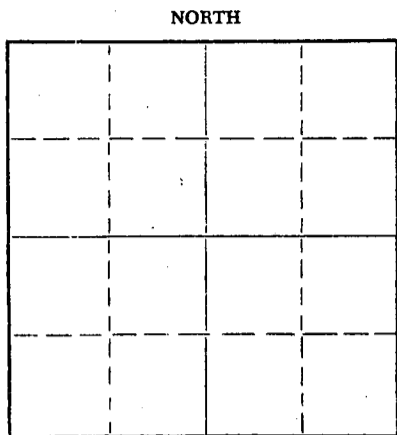

Locate well correctly on above Section Plat

If a producing well is abandoned, date of last production _____ 19
Was permission obtained from the Conservation Division or its agents before plugging was commenced? yes

Name of Conservation Agent who supervised plugging of this well Gilbert Licker
Producing formation _____ Depth to top _____ Bottom _____ Total Depth of Well 3815' Feet
Show depth and thickness of all water, oil and gas formations.

OIL, GAS OR WATER RECORDS

CASING RECORD

FORMATION	CONTENT	FROM	TO	SIZE	PUT IN	PULLED OUT

Describe in detail the manner in which the well was plugged, indicating where the mud fluid was placed and the method or methods used in introducing it into the hole. If cement or other plugs were used, state the character of same and depth placed, from _____ feet to _____ feet for each plug set.

1st plug set at 500' with 20 sacks cement.
2nd plug set at 180' with 20 sacks cement.
3rd plug set at 40' with 10 sacks cement.

RECEIVED
STATE CORPORATION COMMISSION
10-22-1959
OCT 22 1959
DIVISION

(If additional description is necessary, use BACK of this sheet)

Name of Plugging Contractor Burch Drilling Co., Inc.
Address 1011 Union Center, Wichita, Kansas

STATE OF KANSAS, COUNTY OF SEDGWICK, ss.
Earl M. Burch, President (employee of owner) or (owner or operator) of the above-described well, being first duly sworn on oath, says: That I have knowledge of the facts, statements, and matters herein contained and the log of the above-described well as filed and that the same are true and correct. So help me God.

(Signature) Earl M. Burch
1011 Union Center, Wichita, Kansas
(Address)

SUBSCRIBED AND SWORN TO before me this 21st day of October, 19 59.

Shirley Ann Anna
Notary Public.

My commission expires March 12, 1963.



15-195-00101-00-00

WELL LOG

Burch Drilling Co., Inc. # 1 McCall
C SE NW, Section 2-11S-23W
Trego County, Kansas

Set 210' 8 5/8" with 165 sacks
COMMENCED: 10-7-59
COMPLETED: 10-15-59
Elevation: 2273 KB

D & A

1565 Shale & Shells
1776 Shale
1800 Anhydrite
1865 Shale & Lime
2275 Shale
3131 Shale & Lime
3275 Lime & Shale
3525 Lime & Shale
3805 Lime
3815 Shale

TOPS

ANHYDRITE 1774
HEEBNER 3531
TORONTO 3554
LANSING 3570

No Drill Stem Tests taken.

STATE OF KANSAS, COUNTY OF SEDGWICK:

I, Earl M. Burch, President of BURCH DRILLING CO., INC. being duly sworn on oath, state: That I have knowledge of the facts, statements and matters herein contained and that the same are true and correct.



Subscribed and sworn to before me this 21st day of October, 1959.


Notary Public

My commission expires: March 12, 1963.

RECEIVED
CORPORATION COMMISSION
10-22-1959
OCT 22 1959
CONSERVATION DIVISION
Wichita, Kansas