


STATE OF KANSAS
STATE CORPORATION COMMISSION

Give All Information Completely
Make Required Affidavit
Mail or Deliver Report to:
Conservation Division
State Corporation Commission
800 Bittig Building
Wichita, Kansas

15-051-00121-00-00

WELL PLUGGING RECORD

NORTH

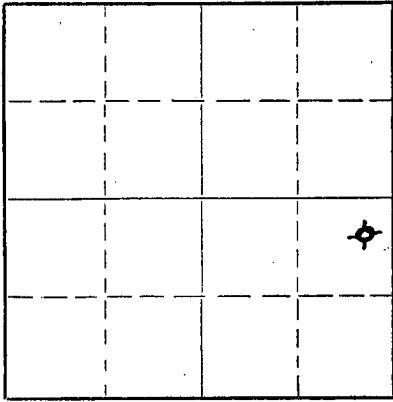

Locate well correctly on above
Section Plat

Ellis County, Sec. 18 Twp. 11S Rge. 19W (E) (W)

Location as "NE/CNW/SW" or footage from lines NE NE SE

Lease Owner Carl Hipple Oil Company

Lease Name Solomon Well No. 1

Office Address 204 Wolcott Bldg., Hutchinson, Kansas

Character of Well (completed as Oil, Gas or Dry Hole) Dry hole

Date well completed December 6 19 52

Application for plugging filed December 6 19 52

Application for plugging approved December 6 19 52

Plugging commenced 8:00 a.m., December 6 19 52

Plugging completed 4:00 p.m., December 6 19 52

Reason for abandonment of well or producing formation
Commercial quantity of oil not found

If a producing well is abandoned, date of last production 19

Was permission obtained from the Conservation Division or its agents before plugging was commenced? yes

Name of Conservation Agent who supervised plugging of this well Eldon Petty

Producing formation _____ Depth to top _____ Bottom _____ Total Depth of Well _____ Feet

Show depth and thickness of all water, oil and gas formations.

OIL, GAS OR WATER RECORDS

CASING RECORD

FORMATION	CONTENT	FROM	TO	SIZE	PUT IN	PULLED OUT
				8 5/8	240'	

Describe in detail the manner in which the well was plugged, indicating where the mud fluid was placed and the method or methods used in introducing it into the hole. If cement or other plugs were used, state the character of same and depth placed, from _____ feet to _____ feet for each plug set.

Set plug at 220' w/15 sacks. Set Plug at 40' w/10 sacks

(If additional description is necessary, use BACK of this sheet)

Name of Plugging Contractor K & E DRILLING, INC.

Address 1006 Central Building, Wichita, Kansas

STATE OF Kansas, COUNTY OF Sedgwick, ss.

Clinton Engstrand, agent for (employee of owner) or (owner or operator) of the above-described well, being first duly sworn on oath, says: That I have knowledge of the facts, statements, and matters herein contained and the log of the above-described well as filed and that the same are true and correct. So help me God.

(Signature) *Clinton Engstrand*
1006 Central Bldg., Wichita, Kansas
(Address)

SUBSCRIBED AND SWORN to before me this 9 day of December, 19 52

My commission expires October 29, 1955

24-2675-5
DEC 11 1952
CONSERVATION DIVISION
Wichita, Kansas
Notary Public.
PLUGGING
FILE SEC 18 T11 R 1924
BOOK PAGE 64 LINE 10

15-051-00121-00-00

CARL HIPPLE OIL COMPANY
NO. 1 SOLOMON

NE NE SE Section 18-11S-19W
Ellis County, Kansas

Casing

Cement

8 5/8" set @ 240'

135 Sacks

Comm: 11-22-52
Comp: 12- 6-52
Total Depth: 3691'

<u>Formation</u>	<u>Depth</u>
Surface soil and sand	0 - 74
Shale	74 - 240
Shale and streaks of sand	240 - 870
Sand and streaks of shale	870 - 1090
Red bed and shale	1090 - 1347
Shale	1347 - 1415
Anhydrite	1415 - 1456
Shale and shells	1456 - 1973
Lime and shale	1973 - 2165
Shale and lime	2165 - 2354
Lime	2354 - 2381
Lime and shale	2381 - 2950
Shale and lime	2950 - 3050
Lime and shale	3050 - 3187
Lime	3187 - 3285
Shale and lime	3285 - 3363
Lime	3363 - 3468
Lime and streaks of shale	3468 - 3555
Lime	3555 - 3585
Conglomerate	3585 - 3602
Lime and shale	3602 - 3656
Shale (green)	3656 - 3658
Arbuckle	3658 - 3691

STATE OF KANSAS)
) SS
SEDGWICK COUNTY)

I hereby certify that the above information is true and correct to the best of my knowledge.

Walter E. Egan

Subscribed and sworn to before me this 9 day of December, 1952.

Widdell Bagus
_____ Notary Public

My Commission Expires: 10-29-55

12-11-1952
COMMISSION DIVISION
WARRANTS, REVENUE

PLUGGING
FILE SEC 18 T 11 R 1934
BOOK PAGE 64 LINE 10