


WELL PLUGGING RECORD

Give All Information Completely  
Make Required Affidavit  
Mail or Deliver Report to:  
Conservation Division  
State Corporation Commission  
211 No. Broadway  
Wichita, Kansas

Sheridan County, Sec. 24 Twp. 9S Rge. (E) 26 (W)

Location as "NE/CNW/SW" or footage from lines C NW NW  
Lease Owner C & G Drilling Company  
Lease Name Corke Well No. 1  
Office Address 107 Ryle Bldg., Wichita, Kansas  
Character of Well (completed as Oil, Gas or Dry Hole) dry hole  
Date well completed 19  
Application for plugging filed May 7, 1963 19  
Application for plugging approved 19  
Plugging commenced May 9 19 63  
Plugging completed May 9 19 63  
Reason for abandonment of well or producing formation dry hole

NORTH

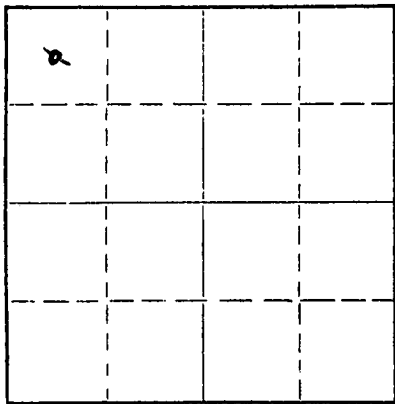

Locate well correctly on above Section Plat

If a producing well is abandoned, date of last production - - - 19  
Was permission obtained from the Conservation Division or its agents before plugging was commenced? yes

Name of Conservation Agent who supervised plugging of this well W. L. Nickols  
Producing formation \_\_\_\_\_ Depth to top \_\_\_\_\_ Bottom \_\_\_\_\_ Total Depth of Well 4170 Feet  
Show depth and thickness of all water, oil and gas formations.

OIL, GAS OR WATER RECORDS

CASING RECORD

FORMATION	CONTENT	FROM	TO	SIZE	PUT IN	PULLED OUT
Surface	185	0	239.23	8 5/8"	239.23	none
		1	4170	5 1/2"	4170	1800

Describe in detail the manner in which the well was plugged, indicating where the mud fluid was placed and the method or methods used in introducing it into the hole. If cement or other plugs were used, state the character of same and depth placed, from \_\_\_\_\_ feet to \_\_\_\_\_ feet for each plug set.

Sanded back to 3900 feet  
Set 5 sacks cement with dump bailer  
Fill hole with mud to 550 feet; circulated mud,  
Pumped 20 sacks cement at 550 feet;  
filled hole with mud to 210 feet, circulated 20 sacks cement at 210,  
filled hole with mud to 35 feet, set rock bridge, dumped 10 sacks  
cement, cement returning to bottom of cellar.

RECEIVED  
STATE CORPORATION COMMISSION  
5-24-63  
MAY 24 1963

CONSERVATION DIVISION  
Wichita, Kansas


(If additional description is necessary, use BACK of this sheet)  
Name of Plugging Contractor Pipe Pullers, Inc.,  
Address Ellinwood, Kansas

STATE OF Kansas, COUNTY OF Barton, ss.  
Dean Wells (employee of owner) or (owner or operator) of the above-described well, being first duly sworn on oath, says: That I have knowledge of the facts, statements, and matters herein contained and the log of the above-described well as filed and that the same are true and correct. So help me God.

(Signature) Dean Wells  
Ellinwood, Kansas.

(Address)

SUBSCRIBED AND SWORN to before me this 11 day of May, 19 63

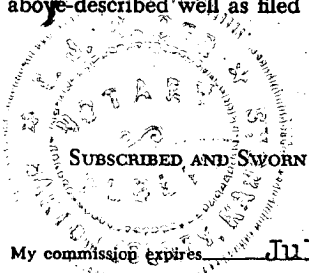

I. J. Rader  
Notary Public.

My commission expires July 7, 1964.

WELL LOG

OPERATOR C G Drilling Co. - R. W. Shields

SEC. 24-9S-26W

WELL NAME Corke #1

LOC. C NW NW

TOTAL DEPTH 4170'

COUNTY Sheridan

DRILLING

DRILLING

COMM. 12/20/62

COMP. 1/1/63

STATE Kansas

RIG NO. 2

ELEVATION 2663 K.B.

CASING: 239.23' (6 jts) 8-5/8" OD Surface  
2370' of 5-1/2" OD Casing

PRODUCTION: Abandoned  
May 9, 1963

All measurements taken from the top of rotary bushing.

FROM	TO	FORMATION	DEVIATION FROM VERTICAL	REMARKS:
0	575	Shale		
575	1590	Shale-Sand	800' - 0°	
1590	1755	Shale	1800' - 0°	
1755	1860	Shale-Sand		
1860	2308	Red Bed	2975' - 0°	
2308	2343	Anhydrite		
2343	2815	Shale-Shells		
2815	2945	Shale-Lime		
2945	4030	Lime-Shale		
4030	4127	Lime		
4127	4170	Lime-Shale		

DST #1 4063-4102  
DST #2 4102-4122

RECEIVED  
STATE CORPORATION COMMISSION

MAY 24 1963

CONSERVATION DIVISION  
Wichita, Kansas

STATE OF KANSAS )  
                          ) SS.  
COUNTY OF SEDGWICK)

The undersigned hereby certifies that to the best of his knowledge and belief, the above facts are true and correct.

C-G DRILLING CO.

By G. F. Galloway  
G. F. Galloway

THIS 23 day of May, 1963.

Vicky Jacobs  
Vicky Jacobs - Notary Public

