


STATE OF KANSAS  
STATE CORPORATION COMMISSION

Give All Information Completely  
Make Required Affidavit  
Mail or Deliver Report to:  
Conservation Division  
State Corporation Commission  
211 No. Broadway  
Wichita, Kansas

WELL PLUGGING RECORD

~~15-179-05599-0000~~  
15-179-05599-00-01

NORTH

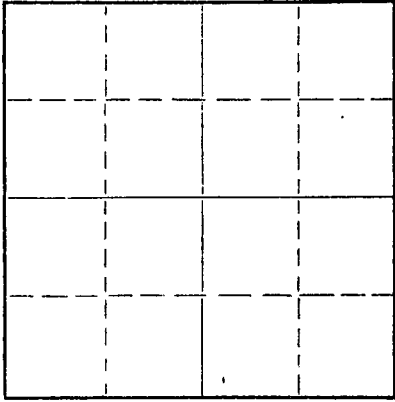

Locate well correctly on above  
Section Plat

SHERIDAN County. Sec. 17 Twp. 9 Rge. 26 (E) W (W)  
Location as "NE/CNW/SW" or footage from lines C W/2 W/2 NE  
Lease Owner EMPIRE DRILLING COMPANY  
Lease Name MILLS Well No. 2  
Office Address 400 BROWN BUILDING, WICHITA 2, KANSAS  
Character of Well (completed as Oil, Gas or Dry Hole) DRY HOLE  
Date well completed MARCH 18 1956  
Application for plugging filed MARCH 18 1956  
Application for plugging approved MARCH 18 1956  
Plugging commenced MARCH 18 1956  
Plugging completed MARCH 18 1956  
Reason for abandonment of well or producing formation DRY HOLE

If a producing well is abandoned, date of last production 19  
Was permission obtained from the Conservation Division or its agents before plugging was commenced? YES

Name of Conservation Agent who supervised plugging of this well ELDON PETTY  
Producing formation Depth to top Bottom Total Depth of Well 4010 Feet  
Show depth and thickness of all water, oil and gas formations.

OIL, GAS OR WATER RECORDS

CASING RECORD

FORMATION	CONTENT	FROM	TO	SIZE	PUT IN	PULLED OUT

Describe in detail the manner in which the well was plugged, indicating where the mud fluid was placed and the method or methods used in introducing it into the hole. If cement or other plugs were used, state the character of same and depth placed, from feet to feet for each plug set.

BOTTOM PLUG SET AT 280' WITH 1/2 SACK HULLS AND 15 SACKS CEMENT.  
TOP PLUG SET AT 40' WITH 1/2 SACK HULLS AND 10 SACKS OF CEMENT.

(If additional description is necessary, use BACK of this sheet)

Name of Plugging Contractor EMPIRE DRILLING COMPANY  
Address 400 BROWN BUILDING, WICHITA 2, KANSAS

STATE OF KANSAS, COUNTY OF SEDGWICK, ss.  
I, DAN J. KORNFELD (employee of owner) or (owner) or operator of the above-described well, being first duly sworn on oath, says: That I have knowledge of the facts, statements, and matters herein contained and the log of the above-described well as filed and that the same are true and correct. So help me God.

(Signature) *Dan J. Kornfeld*  
DAN J. KORNFELD  
400 BROWN BUILDING, WICHITA 2, KANSAS  
(Address)

SUBSCRIBED AND SWORN to before me this 26TH day of MARCH, 1956  
My commission expires JUNE 7, 1956

*Charlotte Kletchka*  
CHARLOTTE KLETCHKA  
Notary Public.



**PLUGGING**  
FILE SEC. 17 T. 9 R. 26 W.  
BOOK PAGE 47 LINE 33

3-27-56  
MAR 27 1956  
CONSERVATION DIVISION  
WICHITA, KANSAS

L O G

COMPANY: EMPIRE DRILLING COMPANY  
 CONTRACTOR: EMPIRE DRILLING COMPANY  
 FARM: MILLS No. 2  
 LOCATION: C W/2 W/2 NE, SEC. 17-9-26  
 SHERIDAN COUNTY, KANSAS  
 COMMENCED: 3-8-56  
 COMPLETED: 3-18-56

0	TO	765	WASHED OUT OLD HOLE
765	TO	2270	SHALE
2270	TO	2307	ANHYDRITE
2307	TO	2580	SHALE
2580	TO	2797	SHALE AND SHELLS
2797	TO	3865	SHALE AND LIME
3865	TO	4010	LIME
4010			R.T.D.

USED SURFACE CASING IN OLD HOLE.

ELEVATION: 2696 K.B.

TOPS: ANHYDRITE 2270'; HEEBNER 3793'; TORONTO 3812'; LANSING KANSAS CITY 3832'; R.T.D. 4010'.

D.S.T. No. 1 3850-3865 OPEN 1 HR. FAIR TO WEAK BLOW THROUGHOUT; RECOVERED 90' SLIGHTLY WATERY OIL CUT MUD; 10' OIL; 170' OF SLIGHTLY OIL CUT WATER; 30 MINUTE B.H.P. 1,080#.

D.S.T. No. 2 3950-3965 OPEN 2 1/2 HRS. VERY WEAK INTERMITTENT BLOW FOR 1 1/2 HRS. RECOVERED 10' MUD WITH RAINBOW SHOW OF OIL; 30 MINUTE B.H.P. "0".

D.S.T. No. 3 3950-4010 OPEN 1 HR. WEAK BLOW FOR 10 MINUTES. RECOVERED 20' MUD; 30 MIN. B.H.P. "0".

D & A

C E R T I F I C A T I O N

I, DAN J. KORNFELD, DO HEREBY CERTIFY THAT THE ABOVE AND FOREGOING IS A TRUE AND CORRECT COPY OF THE LOG ON THE MILLS NO. 2, C W/2 W/2 NE, SEC. 17, TOWNSHIP 9 SOUTH, RANGE 26 WEST, SHERIDAN COUNTY, KANSAS, AS REFLECTED BY THE FILES OF THE EMPIRE DRILLING COMPANY.

*Dan J. Kornfeld*  
DAN J. KORNFELD

SUBSCRIBED AND SWORN TO BEFORE ME A NOTARY PUBLIC WITHIN AND FOR SEDGWICK COUNTY, KANSAS, THIS 26TH DAY OF MARCH, 1956.

MY COMMISSION EXPIRES JUNE 7, 1956

*Charlotte Kletchka*  
NOTARY PUBLIC  
CHARLOTTE KLETCHKA



**PLUGGING**  
FILE SEC. 17 T. 9 R. 26W  
BOOK PAGE 47 LINE 33