

STATE OF KANSAS  
STATE CORPORATION COMMISSION

WELL PLUGGING RECORD

Give All Information Completely  
Make Required Affidavit  
Mail or Deliver Report to:  
Conservation Division  
State Corporation Commission  
800 Biting Building  
Wichita, Kansas

Sheridan County. Sec. 17 Twp. 9S Rge. (E) 26 (W)

Location as "NE/CNW/SW" or footage from lines NW NW NE

Lease Owner Graham-Messman-Rinehart Oil Company

Lease Name Mills Well No. 1

Office Address 1005 East Second, Wichita, Kansas

Character of Well (completed as Oil, Gas or Dry Hole) Oil

Date well completed June 7, 1952 19

Application for plugging filed Jan. 8, 1955 19

Application for plugging approved Jan. 8, 1955 19


Plugging commenced Jan. 10, 1955 19

Plugging completed Jan. 16, 1955 19

Reason for abandonment of well or producing formation Well no longer capable of producing commercial quantity.

If a producing well is abandoned, date of last production Dec. 20, 1954 19

Was permission obtained from the Conservation Division or its agents before plugging was commenced? Yes

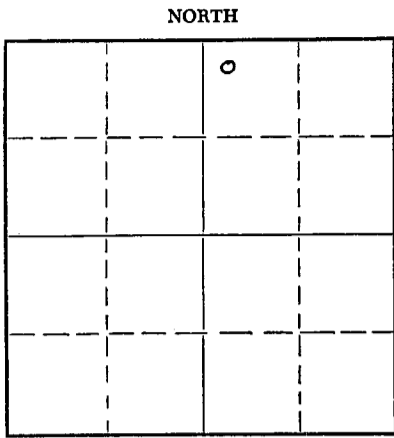

Locate well correctly on above Section Plat

Name of Conservation Agent who supervised plugging of this well Eldon Petty, Box 326, Hays, Kansas

Producing formation Lansing-K.C. Depth to top 3830 Bottom 4066 Total Depth of Well 4452 Feet

Show depth and thickness of all water, oil and gas formations.

OIL, GAS OR WATER RECORDS

CASING RECORD

FORMATION	CONTENT	FROM	TO	SIZE	PUT IN	PULLED OUT
				8 5/8"	290'	None
				5 1/2"	4090'	1301'

Describe in detail the manner in which the well was plugged, indicating where the mud fluid was placed and the method or methods used in introducing it into the hole. If cement or other plugs were used, state the character of same and depth placed, from \_\_\_\_\_ feet to \_\_\_\_\_ feet for each plug set.

Plug set at 4045'. Plugged back with crushed rock from 4045' to 4010'. Dumped 4 sacks cement at 4010' with dump bailer. Top of cement 3895'. Filled hole with mud to 290'. Set rock bridge, dumped 15 sacks cement. Top of cement 230'. Filled with mud to 35', set rock bridge, dumped 10 sacks cement for cap.

2-2-55

(If additional description is necessary, use BACK of this sheet)

Name of Plugging Contractor J & M Casing Pulling Company (License No. 11)

Address Box 711, Great Bend, Kansas

STATE OF Kansas, COUNTY OF Sedgwick, ss. J. A. Gilliland (employee of owner) ~~and owner~~ of the above-described well, being first duly sworn on oath, says: That I have knowledge of the facts, statements, and matters herein contained and the log of the above-described well as filed and that the same are true and correct. So help me, God.

(Signature) J. A. Gilliland  
1005 East Second, Wichita, Kansas  
(Address)

SUBSCRIBED AND SWORN to before me this 31st day of January, 19 55

Juanita L. Louis  
Notary Public.

My commission expires November 5, 1958

**PLUGGING**  
FILE SEC 17 T 9 R 26 W  
BOOK PAGE 89 LINE 36

MILLS #1

WELL RECORD

Location: NW NW NE Sec. 17-9S-26W  
Sheridan County, Kansas

Commenced: May 17, 1952

Completed: May 31, 1952

Operator: G-M-R Oil Company

Production: Well

Contractor: G-M-R Oil Company

Elevation: 2696 R.B.

Casing Record: 8 5/8" @ 290' w/165 sx. cement  
5 1/2" @ 4090' w/100 sx.

LOG

Sand, Clay & Shale	290
Shale	1300
Shale	1748
Anhydrite	1790
Shale	2272
Lime & Shale	2310
Shale & Lime	2450
Shale & Lime	2690
Shale & Lime	2856
Shale & Lime	2970
Shale & Lime	2060
Lime & Shale	3175
Lime & Shale	3255
Lime & Shale	3297
Lime & Shale	3410
Lime & Shale	3518
Lime & Shale	3570
Lime & Shale	3700
Lime & Shale	3800
Lime & Shale	3831
L. Lime	3890
Lime & Shale	3892
Lime	3911
Lime	3930
Lime	3962
Lime	4011
Lime	4034
Lime	4048
Lime	4105
Lime	4144
Lime	4181
Lime	4225
Lime	4250
Lime & Shale	4312
Lime & Shale	4373
Lime & Shale	4404
Lime & Shale	4407
Miss. Chert	4434
Chert Lime	4452 T.D.

TOPS

Hebner	-	3791 (-1095)
Toronto	-	3812 (-1106)
Lansing	-	3830 (-1134)
Base K.C.	-	4066 (-1370)
Merriston	-	4086 (-1390)
Congl.	-	4380 (-1684)
Miss. Chert-	-	4407 (-1711)

The undersigned, Graham-Messman-Rinehart Oil Company, hereby certifies that the above Log is a true and correct Log of the formations encountered in drilling the above well as reflected by the Daily Drilling Reports.

**PLUGGING** GRAHAM-MESSMAN-RINEHART OIL COMPANY  
 PAGE SEC 17 9 R 26W  
 BOOK PAGE 89 LINE 36 BY

*J. A. Hilliland*  
 J. A. Hilliland

Subscribed and sworn to before me this 2nd day of July, 1952.

*Oliver Carter*  
 Notary Public

My commission expires: March 21, 1955