

STATE OF KANSAS  
STATE CORPORATION COMMISSION


Give All Information Completely  
Make Required Affidavit  
Mail or Deliver Report to:  
Conservation Division  
State Corporation Commission  
800 Bitting Building  
Wichita, Kansas

WELL PLUGGING RECORD

Sheridan County. Sec. 17 Twp 9 Rge. (E) 26 (W)

Location as "NE/CNW $\frac{1}{4}$ SW $\frac{1}{4}$ " or footage from lines SE NW NE  
Lease Owner Graham-Messner-Rinehart Oil Company  
Lease Name Mills Well No. 3  
Office Address P. O. Box 1033, Wichita, Kansas  
Character of Well (completed as Oil, Gas or Dry Hole) Dry Hole  
Date well completed January 30, 1953  
Application for plugging filed February 21, 1953  
Application for plugging approved February 19, 1953  
Plugging commenced February 11, 1953  
Plugging completed February 11, 1953  
Reason for abandonment of well or producing formation Dry Hole

NORTH

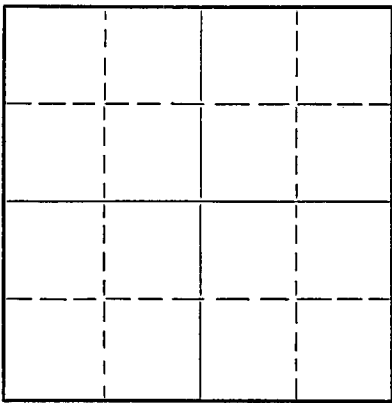

Locate well correctly on above  
Section Plat

If a producing well is abandoned, date of last production 19...  
Was permission obtained from the Conservation Division or its agents before plugging was commenced? YES

Name of Conservation Agent who supervised plugging of this well Mr. Eldon Petty, Box 326, Hays, Kansas  
Producing formation... Depth to top... Bottom... Total Depth of Well 4030 Feet  
Show depth and thickness of all water, oil and gas formations.

OIL, GAS OR WATER RECORDS

CASING RECORD

Formation	Content	From	To	Size	Put In	Pulled Out
				8 5/8"	305'	none
				5 1/2"	1,067.58'	3,473.06'
					SS	
					PT	
					K.C.	

Describe in detail the manner in which the well was plugged, indicating where the mud fluid was placed and the method or methods used in introducing it into the hole. If cement or other plugs were used, state the character of same and depth placed, from... feet to... feet for each plug set.

Plugged back with crushed rock from 4030' to 4010'.  
Dumped 5 sx. of cement at 4010' with dump bailer.  
Top of cement 3975'. Filled with mud to 305', set rock bridge, dumped 15 sx. cement, top of cement 260'. Filled hole with mud to 35', set rock bridge dumped 10 sx. for cap.

2-25-53

(If additional description is necessary, use BACK of this sheet)

Name of Plugging Contractor Miller Casing Pulling Company  
Address P. O. Box 711, Great Bend, Kansas

STATE OF Kansas, COUNTY OF Sedgewick, ss.  
J. A. Gilliland (employee of owner) as owner and operator of the above-described well,


being first duly sworn on oath, says: That I have knowledge of the facts, statements, and matters herein contained and the log of the above-described well as filed and that the same are true and correct. So help me God.

(Signature) J. A. Gilliland  
P. O. Box 1033, Wichita, Kansas (Address)

SUBSCRIBED AND SWORN to before me this 21th day of February, 1953.

My commission expires December 1, 1956

Barbara J. Scott  
Notary Public.

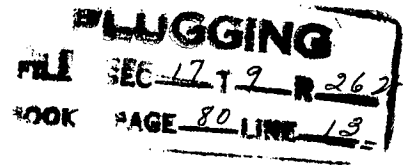

MILLS # 3

WELL RECORD

Location: SE-NW-NE Sec. 17-9-26  
Sheridan County, Kansas

Commenced: January 19, 1953

Operator: G-M-R Oil Company

Completed: January 30, 1953

Contractor: G-M-R Oil Company

Production: D. & A.

Casing Record: 8 5/8" @305' w/ 165 sx. cement

Elevation: 2690 K.B.

L-0-0

Soil & Clay	135
Sand & Shale	275
Blue Shale	306
Shale	860
Shale & Sand	1375
Shale & Lime	1705
Shale & Lime	1741
Shale & Shells	1783
Anhydrite	1820
Shale	1822
Lime & Shale	2258
Anhydrite	2280
Brown Lime	2430
Lime	2592
Lime & Shale	2730
Shale & Lime & Shells	2925
Shale & Lime	2997
Lime & Shale	3150
Brown Lime	3235
Lime & Shale	3325
Lime & Shale	3413
Shale & Lime	3525
Shale & Lime	3642
Lime & Shale	3719
Brown Lime	3815
Lime	3840
Lime	3915
Lime	3922
Lime	3970
Lime & Shale	4030 T.D.

TOPS

Heebner	3782 (-1092)
Toronto	3801 (-1111)
Lansing	3820 (-1130)

The undersigned, Graham-Messman-Rinehart Oil Company, hereby certifies that the above log is a true and correct log of the formations encountered in drilling the above well as reflected by the Daily Drilling Reports.

GRAHAM-MESSMAN-RINEHART OIL COMPANY

By J. A. Gilliland  
J. A. Gilliland

Subscribed and sworn to before me this 16th day of February, 1953.

Barbara J. Scott  
Notary Public

My commission expires December 1, 1956.