

STATE OF KANSAS
STATE CORPORATION COMMISSION

WELL PLUGGING RECORD

Give All Information Completely
Make Required Affidavit
Mail or Deliver Report to
Conservation Division
State Corporation Comm.
245 North Water
Wichita, KS 67202

Sheridan County. Sec. 7 Twp. 9S Rge. 28 ~~XX~~W

Location as "NE/CNW $\frac{1}{4}$ /SW $\frac{1}{4}$ " or footage from lines
2310' from north line and 2310' from west line

Lease Owner Texas Oil & Gas Corp.

Lease Name Shaw Well No. C-1

Office Address 200 W. Douglas, Wichita, Kansas 67202

Character of Well (Completed as Oil, Gas or Dry Hole)
Dry Hole

Date Well completed 01-19 1979

Application for plugging filed 01-19 1979

Application for plugging approved 01-19 1979

Plugging commenced 01-19 1979

Plugging completed 01-19 1979

Reason for abandonment of well or producing formation
Dry Hole


If a producing well is abandoned, date of last production
19

Was permission obtained from the Conservation Division or
its agents before plugging was commenced? yes

Name of Conservation Agent who supervised plugging of this well Gilbert Balthazor

Producing formation Depth to top Bottom Total Depth of Well 4130

Show depth and thickness of all water, oil and gas formations.

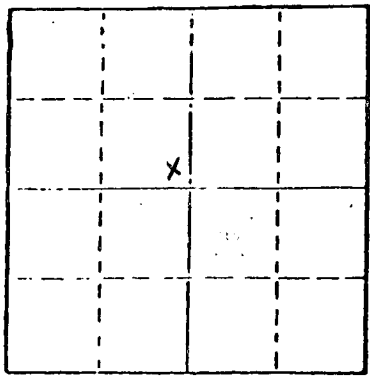

Locate well correctly on above
Section Plot

OIL, GAS OR WATER RECORDS

CASING RECORD

FORMATION	CONTENT	FROM	TO	SIZE	PUT IN	PULLED OUT
				8 5/8	268	-0-

Describe in detail the manner in which the well was plugged, indicating where the mud fluid
was placed and the method or methods used in introducing it into the hold. If cement or other
plugs were used, state the character of same and depth placed, from feet to
feet for each plug set.

mud laden fluid	-	4130	-	1250
70 scks	-		-	1250
20 scks	-		-	240
10 scks	-		-	40
5 scks	-		-	rathole
50-50 Poz	-		-	6% gel

(If additional description is necessary, use BACK of this sheet)

Name of Plugging Contractor Western Petroleum, Inc.

STATE OF Kansas COUNTY OF Thomas, ss.
Roy F. Senior Jr. (employee of owner) or (owner or operator)

of the above-described well, being first duly sworn on oath, says: That I have knowledge of
the facts, statements, and matters herein contained and the log of the above-described well
as filed and that the same are true and correct. So help me God.

(Signature) Roy F. Senior Jr.
P.O. Box 852, Colby, Kansas 67701


(Address)

SUBSCRIBED AND SWORN TO before me this 23 rd day of January, 1979

My commission expires May 18 1980

Del. Notary Public.

RECEIVED
1-31-79
JAN 31 1979
CONSERVATION DIVISION
Wichita, Kansas

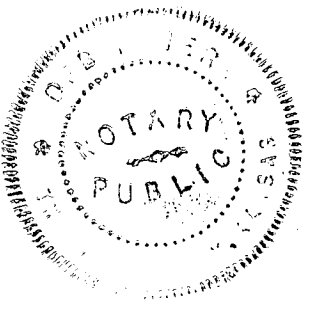

OPERATOR:

Texas Oil & Gas Corp.
200 W. Douglas - Suite 300
Wichita, Kansas 67202

CONTRACTOR:

Western Petroleum, Inc.
P.O. Box 852
Colby, Kansas 67701

LEASE:

Shaw

WELL:

C-1

LOCATION:

Sheridan County
7 - 9S - 28W
2310' FNL and 2310' FWL

TOTAL DEPTH:

4130'

ELEVATION:

2725' G.L. 2734' K.B.

COMMENCED:

December 30, 1978

COMPLETED:

January 19, 1979

CASING

N/A- 8-5/8" @ 268' w/250 sx cmt

STATUS:

Dry Hole

DEPTHS AND FORMATIONS

(All measurements from K. B.)

- Stone Corral ~ 2320'
- Topeka ~ 3575'
- Heebner ~ 3785'
- Lansing ~ 3815'
- Base Kansas City ~ 4060'
- R, T, D. ~ 4130'

RECEIVED
STATE CORPORATION COMMISSION
JAN 31 1979
CONSERVATION DIVISION
Wichita, Kansas

STATE OF KANSAS)
COUNTY OF THOMAS) ss

I, Roy F. Senior Jr. of Western Petroleum, Inc. state that

the above foregoing is true and correct log of the above captioned wells.

Roy F. Senior Jr.

Subscribed and sworn to before me this 23 rd day of January 1979

My Commission Expires May 18 1980

Del Meier
Notary Public

