

15-179-30178-0000

STATE OF KANSAS  
STATE CORPORATION COMMISSION

WELL PLUGGING RECORD


DEC 30 1958

Give All Information Completely  
Make Required Affidavit  
Mail or Deliver Report to:  
Conservation Division  
State Corporation Commission  
211 No. Broadway  
Wichita, Kansas

Sheridan County. Sec. 6 Twp. 9s Rge. (E) 28 (W)

Location as "NE/CNW/SW" or footage from lines SW NW  
Lease Owner Oil Property Management, Inc.  
Lease Name DECKER "A" Well No. 3  
Office Address 603 Orpheum Building, Wichita, Kansas  
Character of Well (completed as Oil, Gas or Dry Hole) Dry  
Date well completed 12/19 19 58  
Application for plugging filed 12/19 19 58  
Application for plugging approved 12/19 19 58  
Plugging commenced 12/19 19 58  
Plugging completed 12/19 19 58  
Reason for abandonment of well or producing formation Dry

NORTH

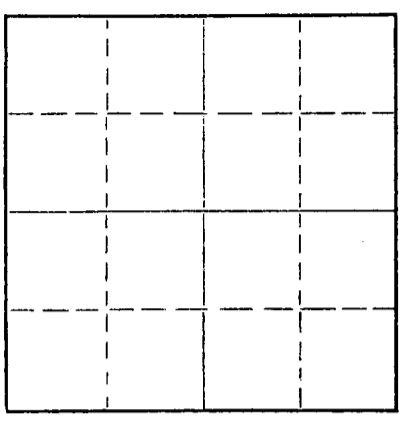

Locate well correctly on above  
Section Plat

If a producing well is abandoned, date of last production \_\_\_\_\_ 19\_\_\_\_  
Was permission obtained from the Conservation Division or its agents before plugging was commenced? yes

Name of Conservation Agent who supervised plugging of this well Mr. Fabricius, Hill City, Kansas  
Producing formation \_\_\_\_\_ Depth to top \_\_\_\_\_ Bottom \_\_\_\_\_ Total Depth of Well 3865 Feet  
Show depth and thickness of all water, oil and gas formations.

OIL, GAS OR WATER RECORDS

CASING RECORD

FORMATION	CONTENT	FROM	TO	SIZE	PUT IN	PULLED OUT
				8-5/8"	224	None

Describe in detail the manner in which the well was plugged, indicating where the mud fluid was placed and the method or methods used in introducing it into the hole. If cement or other plugs were used, state the character of same and depth placed, from \_\_\_\_\_ feet to \_\_\_\_\_ feet for each plug set.

- First plug set at 600 feet with 20 sacks cement.
- Second plug set at 225 feet with 20 sacks cement.
- Third plug set at 40 feet with 10 sacks cement.

REC'D  
STATE CORP. COMMISSION  
1-10-59  
JAN 10 1959  
CONSERVATION DIVISION  
Wichita, Kansas

(If additional description is necessary, use BACK of this sheet)

Name of Plugging Contractor JOHN O. FARMER, INC.  
Address Russell, Kansas

STATE OF Kansas, COUNTY OF Russell, ss.  
I, John O. Farmer (employee of owner) or (owner or operator) of the above-described well, being first duly sworn on oath, says: That I have knowledge of the facts, statements, and matters herein contained and the log of the above-described well as filed and that the same are true and correct. So help me God.

(Signature) John O. Farmer  
Russell, Kansas  
(Address)

SUBSCRIBED AND SWORN TO before me this 29th day of December, 19 58

My commission expires October 11, 1962

Lucille Kennedy  
Lucille Kennedy  
Notary Public.

PLUGGING  
FILE SEC 6 T. 9 R. 28w  
BOOK PAGE 9 LINE 17

