


WELL PLUGGING RECORD

Give All Information Completely
Make Required Affidavit
Mail or Deliver Report to:
Conservation Division
State Corporation Commission
211 No. Broadway
Wichita, Kansas

NORTH

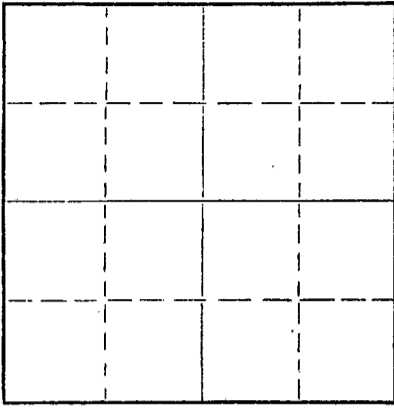

Locate well correctly on above
Section Plat

Ellis County. Sec. 4 Twp. 11 Rge. 18 (E) 18 (W)
Location as "NE/CNW/SW" or footage from lines NW NW SW
Lease Owner Thunderbird Drilling, Inc.
Lease Name Martin Well No. 1
Office Address 712 Union Center, Wichita, Kansas
Character of Well (completed as Oil, Gas or Dry Hole) Dry Hole
Date well completed Feb. 25, 19 57
Application for plugging filed Feb. 25, 19 57
Application for plugging approved Feb. 25, 19 57
Plugging commenced Feb. 25, 19 57
Plugging completed Feb. 25, 19 57
Reason for abandonment of well or producing formation Dry Hole

If a producing well is abandoned, date of last production 19
Was permission obtained from the Conservation Division or its agents before plugging was commenced? Yes

Name of Conservation Agent who supervised plugging of this well Mr. Eldon Petty
Producing formation _____ Depth to top _____ Bottom _____ Total Depth of Well 3723' Feet
Show depth and thickness of all water, oil and gas formations.

OIL, GAS OR WATER RECORDS

CASING RECORD

FORMATION	CONTENT	FROM	TO	SIZE	PUT IN	PULLED OUT
		0	220'	8 5/8"	224.36'	None

Describe in detail the manner in which the well was plugged, indicating where the mud fluid was placed and the method or methods used in introducing it into the hole. If cement or other plugs were used, state the character of same and depth placed, from _____ feet to _____ feet for each plug set.

Halliburton plug pushed to 400' with drillpipe. 25 sacks of cement mixed and poured through drillpipe. Hole filled with mud to 40'. Halliburton plug and 1/3 sack of cement pushed to 40'. 10 sacks cement mixed and poured on top of plug.

RECEIVED
STATE CORPORATION COMMISSION
3-2-1957
MAR 2 - 1957

(If additional description is necessary, use BACK of this sheet)
Name of Plugging Contractor Thunderbird Drilling, Inc.
Address 712 Union Center, Wichita, Kansas

STATE OF KANSAS COUNTY OF SEDGWICK
Charles W. Aikins, Jr. (employee of owner) or (owner or operator) of the above-described well, being first duly sworn on oath, says: That I have knowledge of the facts, statements, and matters herein contained and the log of the above-described well as filed and that the same are true and correct. So help me God.

(Signature) Charles W. Aikins, Jr.
712 Union Center, Wichita, Kansas
(Address)

SUBSCRIBED AND SWORN TO before me this 1st day of March, 19 57

My commission expires _____ Notary Public.

JENELL SCHATZ, Notary Public
My Commission Expires Sept. 5, 1960

PLUGGING
FILE SEC. 4 T. 11 R. 18W
BOOK PAGE 145 LINE 15

MARTIN #1

LOCATION: NW NW SW - Sec. 4,
Twp. 11.S, Rge. 18.W,
Ellis County, Kansas

CONTRACTOR: Thunderbird Drilling, Inc.
712 Union Center
Wichita, Kansas

SURFACE CASING: 8 5/8" set at 220' with
130 sacks of cement, 1% gel
and 2 sacks Calcium Chloride.

OIL STRING: None

ELEVATION: 2072' K. B.
2069' D. F.
2067' G. L.

COMMENCED: February 15, 1957

COMPLETED: February 25, 1957

WELL LOG

0	-	70	Surface soil and rock
70	-	450	Shale
450	-	660	Shale & Sand
660	-	800	Sand
800	-	1130	Shale & Sand
1130	-	1270	Red Bed
1270	-	1400	Shale & Shells
1400	-	1435	Anhydrite
1435	-	1985	Shale & Shells
1985	-	2250	Lime
2250	-	2435	Lime & Shale
2435	-	3500	Shale & Shells
3500	-	2925	Lime and Shale
2925	-	3075	Lime
3075	-	3226	Lime and Shale
3226	-	3565	Lime
3565	-	3613	Lime, Shale & Chert
3613	-	3665	Chert & Lime
3665	-	3699	Lime & Shale
3699	-	3723	Arbuckle
3723			Rotary Total Depth

The undersigned, Charles W. Aikins, Jr., an officer of Thunderbird Drilling, Inc., hereby certifies that the above is a true and correct log of the formations encountered in the drilling of the #1 Martin as shown in the daily drilling reports.

THUNDERBIRD DRILLING, INC.

[Signature]
Charles W. Aikins, Jr., Pres.

Subscribed and sworn to before me
this 1st day of March, 1957.

[Signature]
JENELL SCHARTZ, Notary Public
My Commission Expires Sept. 5, 1960

RECEIVED
STATE CORPORATIONS COMMISSION
3-2-1957
MAR 2 - 1957

CONSERVATION DIVISION
Wichita, Kansas
PLUGGING
FILE SEC 4 T 11 R 18w
BOOK PAGE 145 LINE 15