


WELL PLUGGING RECORD

Give All Information Completely
Make Required Affidavit
Mail or Deliver Report to:
Conservation Division
State Corporation Commission
212 North Market, Insurance Bldg.
Wichita, Kansas

NORTH

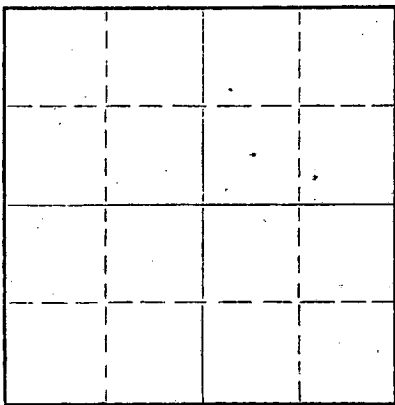

Locate well correctly on above Section Plat

Ellis County. Sec. 4 Twp. 11S Rge. (E) 18 (W)
Location as "NE/CNW/SW" or footage from lines SE SW SW
Lease Owner Chief Drilling Co., Inc. and Petroleum, Inc.
Lease Name Martin "C" Well No. 1
Office Address Box 97, Great Bend, Kansas
Character of Well (completed as Oil, Gas or Dry Hole) Dry Hole
Date well completed May 22 1960
Application for plugging filed May 22 1960
Application for plugging approved May 22 1960
Plugging commenced May 22 1960
Plugging completed May 22 1960
Reason for abandonment of well or producing formation

If a producing well is abandoned, date of last production 19
Was permission obtained from the Conservation Division or its agents before plugging was commenced? yes

Name of Conservation Agent who supervised plugging of this well Eldon Petty, Hays, Kansas
Producing formation Depth to top Bottom Total Depth of Well 3630 Feet
Show depth and thickness of all water, oil and gas formations.

OIL, GAS OR WATER RECORDS

CASING RECORD

FORMATION	CONTENT	FROM	TO	SIZE	PUT IN	PULLED OUT
				8-5/8"	254'	None

Describe in detail the manner in which the well was plugged, indicating where the mud fluid was placed and the method or methods used in introducing it into the hole. If cement or other plugs were used, state the character of same and depth placed, from feet to feet for each plug set.

1/3 sx hulls and wooden plug set at 550', mixed 20 sx cement thru drill pipe.

1/3 sx hulls and wooden plug set at 180', mixed 15 sx cement thru drill pipe.

1/3 sx hulls and wooden plug set at 40', mixed 10 sx cement.

RECEIVED
STATE CORPORATION COMMISSION
5-27-1960
MAY 27 1960

CONSERVATION DIVISION
Wichita, Kansas

(If additional description is necessary, use BACK of this sheet)
Name of Plugging Contractor Chief drilling Co., Inc.
Address Box 97, Great Bend, Kansas

STATE OF KANSAS, COUNTY OF BARTON, ss.
V. Richard Hoover (employee of owner) or (owner or operator) of the above-described well, being first duly sworn on oath, says: That I have knowledge of the facts, statements, and matters herein contained and the log of the above-described well as filed and that the same are true and correct. So help me God.

(Signature) V. Richard Hoover
Box 97, Great Bend, Kansas
(Address)

SUBSCRIBED AND SWORN TO before me this 26th day of May, 1960
My commission expires June 18, 1963
Dorothy B. John
Dorothy B. John Notary Public.



15-051-01131-00-00

WELL LOG

Chief Drilling Co., Inc. & Petroleum, Inc.
P.O. Box 97
Great Bend, Kansas

No. 1 Martin "C"
SE SW SW Sec. 4-11S-18W
Ellis County, Kansas

Contractor: Chief Drilling Co., Inc.

Commenced: 5-9-60
Completed: 5-22-60
D&A

Rotary: 0 - 3630'

Casing Record: 8-5/8" @ 254' cemented with 175 sacks, cement circulated

<u>FORMATION</u>	<u>FROM</u>	<u>TO</u>	<u>ELEVATION</u>
Post Rock & Shale	0	50	2027' Gr.
Shale & Sand	50	254	2029' D.F.
Shale & Shells	254	450	2032' K.B.
Redbed & Shells	450	525	
Sand	525	610	
Shale, Shells & Sand	610	810	
Sand	810	985	
Shale & Shells	985	1314	
Shale & Shells	1314	1354	
Anhydrite	1354	1387	
Shale & Shells	1387	1460	
Shale	1460	1800	
Shale & Shells	1800	2150	
Shale & Lime	2150	2300	
Lime	2300	2430	
Shale & Lime	2430	2645	
Lime	2645	2800	
Shale & Lime	2800	3017	
Lime	3017	3236	
Shale & Lime	3236	3276	
Lime	3276	3500	
Lime & Shale	3500	3533	
Chert	3533	3584	
Shale w/Sand Streaks	3584	3602	
Dolomite & Shale	3602	3621	
Dolomite	3621	3630	
Total Depth	3630		

FORMATION TOPS

Anhydrite	1354 (+ 678)
Topeka	3017 (- 95)
Heebner	3236 (-1204)
Toronto	3251 (-1219)
Lansing	3276 (-1244)
Base Kansas City	3500 (-1468)
Cherty Conglo.	3533 (-1501)
Simpson Shale	3584 (-1552)
Simpson Dolomite	3602 (-1570)
Arbuckle	3621 (-1589)
Total Depth	3630 (-1598)

RECEIVED
STATE CORPORATION COMMISSION
5-27-1960
MAY 27 1960
CONSERVATION DIVISION
Wichita, Kansas

STATE OF KANSAS, COUNTY OF BARTON, SS.

I hereby certify that the above is a true and correct copy of the Driller's Log of the well drilled in the SE SW SW Sec. 4-11S-18W, Ellis County, Kansas to the best of my knowledge and belief.



CHIEF DRILLING CO., INC.

V. Richard Hoover
V. Richard Hoover - President

Subscribed and sworn to before me this 26th day of May, 1960.

Dorothy B. John
Dorothy B. John, Notary Public

My commission expires 6/18/63