


15-065-00323-0002

STATE OF KANSAS
STATE CORPORATION COMMISSION

Form CP-4

Give All Information Completely
Make Required Affidavit
Mail or Deliver Report to:
Conservation Division
State Corporation Commission
P. O. Box 17027
Wichita, Kansas 67217
NORTH

WELL PLUGGING RECORD

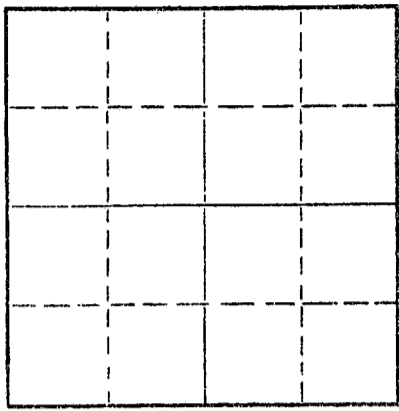

Locate well correctly on above
Section Plat

Graham County. Sec. 28 Twp. 9 Rge. 25 (E) (W) X
Location as "NE/CNW&SW" or footage from lines. SW SW SW
Lease Owner Bankoff Oil Co.
Lease Name Bolliq Well No. #1
Office Address 1119 Sherman Great Bend, Kansas
Character of Well (completed as Oil, Gas or Dry Hole) _____
Date well completed _____ 19____
Application for plugging filed 3-3-72 19____
Application for plugging approved _____ 19____
Plugging commenced 3-29-72 19____
Plugging completed 3-31-72 19____
Reason for abandonment of well or producing formation _____
If a producing well is abandoned, date of last production _____ 19____
Was permission obtained from the Conservation Division or its agents before plugging was commenced? _____

Name of Conservation Agent who supervised plugging of this well W. L. Nichols
Producing formation _____ Depth to top _____ Bottom _____ Total Depth of Well 4090' Feet
Show depth and thickness of all water, oil and gas formations.

OIL, GAS OR WATER RECORDS

CASING RECORD

FORMATION	CONTENT	FROM	TO	SIZE	PUT IN	PULLED OUT
				4 1/2"	4085'	1197.58'
				8 5/8"	231'	

Describe in detail the manner in which the well was plugged, indicating where the mud fluid was placed and the method or methods used in introducing it into the hole. If cement or other plugs were used, state the character of same and depth placed, from _____ feet to _____ feet for each plug set.


Pushed plug to 3850', Sanded back to 3825'. Mixed and ran 4 sacks cement thru dump bailer.
Squeezed hole with 5 sacks hulls and 9 sacks gel. 100 cu. ft. cement from 1275', to 950. 17 sacks gel from 950' to 270'. 30 cu. ft. cement from 270' to 195', 4 sacks gel from 195' to 35', 10 cu. ft. cement from 35' to base of cellar.

RECEIVED
STATE CORPORATION COMMISSION
4-4-72
APR 4 - 1972
CONSERVATION DIVISION
Wichita, Kansas

(If additional description is necessary, use BACK of this sheet)
Name of Plugging Contractor Southwest Casing Pulling Co.
Address Box 364 Great Bend, Kansas

STATE OF Kansas, COUNTY OF Barton, ss.
Southwest Casing Pulling Co. (employee of owner) or (owner or operator) of the above-described well, being first duly sworn on oath, says: That I have knowledge of the facts, statements, and matters herein contained and the log of the above-described well as filed and that the same are true and correct. So help me God.

(Signature) W. C. Spencer Sec.
Box 364 Great Bend, Kansas
(Address)

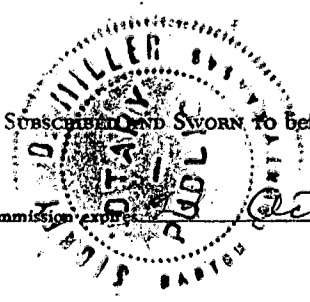

Subscribed and sworn to before me this 3 day of April, 19 72
Sidney D. Miller
Notary Public.